

Hancock County Office Renovations

123 E Main Street
Greenfield, Indiana

Addendum No. 05

CONSTRUCTION MANAGER



Envoy, Inc.

116th Street, Suite 250
Indianapolis, Indiana 46038
Phone: 317.594.4600
Fax: 317.594.4601
www.envoy-cm.com

ARCHITECT / ENGINEER



DLZ Indiana, LLC
138 N. Delaware Street
Indianapolis, Indiana 46204
Phone: 317.633.4120

February 7, 2024

Project: Hancock County Office Renovations

Date: February 7, 2024

By: Envoy, Inc.

ADDENDUM

Number: 05

This addendum is based in accordance with the provisions of "The General Conditions of the Contract for Construction," Article 1, "Contract Documents" and becomes a part of the Contract Documents as provided therein. Bids will be received at the Hancock County Annex in the Commissioner's Court located at 111 South American Legion Place, Suite 101, Greenfield, IN 46140 until **2:00 p.m.** (local time) on **Thursday February 15, 2024.**

Included with this Addendum are the following Notes and Clarifications:

- 1. Addendum # 04 from DLZ is included in this Addendum 05. Mostly Fire Suppression, Plumbing, Mechanical updates plus answers to questions and a Manufacturer approval.**
- 2. For reference, Addendum 04 from Envoy only announced the additional Pre-Bid meeting. Included in this Addendum is the list of Attendees.**
- 3. No other Scope Changes are included with this Addendum.**
- 4. Bids are due at time and date listed above.**
- 5. Basic questions can still be submitted, but this is intended to be the final Addendum prior to the bid.**

ADDENDUM NO. 04

PROJECT: HANCOCK COUNTY OFFICE RENOVATIONS
123 East Main Street
Greenfield, IN 46140
DLZ Project Number 2163-1063-90

TO: All Bidders and others to whom Plans and Specifications
for the above referenced Project have been issued.


OWNER: Hancock County Board of Commissioners
111 South American Legion Place, Suite 219
Greenfield, IN 46140

ARCHITECT: DLZ INDIANA, LLC
138 N. Delaware Street.
Indianapolis, Indiana 46204

CERTIFIED BY:

CONSTRUCTION MANAGER: ENVOY CONSTRUCTION
890 E 116th Street, Suite 250
Fishers, Indiana 46038

DATE: February 7, 2024

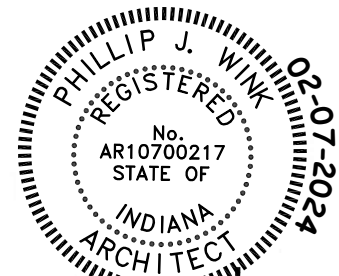

A handwritten signature in black ink, appearing to read "Phillip J. Wink", written over a horizontal line.

Phillip J. Wink, RA
Registered Architect
State of Indiana

The items included in this Addendum are to become a part of the original Drawings and Project Manual dated December 21, 2023 as if included herein. Only these items are to be altered. The remainder of the original Drawings and Project Manual remain valid in their entirety. Bidders must acknowledge receipt of this Addendum in the space provided on the Bid Form. Failure to do so may subject the Bidder to disqualification.

CLARIFICATIONS

ITEM NO. 1. In regards to the extent of mechanical and plumbing work within the Coroners Office Alternate and Public Defenders Alternate, refer to keynotes 221142, 221143, 233112, 233113. These notes contain details pertaining to enclosed regions and scope of work should each alternate be accepted or not. Alternate regions are outlined on sheets in a red dashed line. See also keynotes 022226, 022209, 221112, 221113 and 221319 for more specific details on extent of plumbing work with existing fixtures and mains. (Note: Refer to revisions to Division 22 notes within this Addendum).

PROJECT MANUAL

ITEM NO. 2. SECTION 122113 – HORIZONTAL LOUVER BLINDS
a. Paragraph 2.2B to revise locations. Replace section in its entirety with attached.

- ITEM NO. 3. SECTION 123553.13 – METAL LABORATORY CASEWORK
- a. Add Paragraph 2.1-A.8:
“8. Institutional Casework, Inc. (ICI Scientific)”
 - b. Replace section in its entirety with attached.

- ITEM NO. 4. SECTION 211313 – WET-PIPE SPRINKLER SYSTEMS
- a. Paragraph 2.6.C: Removed branch line testers verbiage.
 - b. Replace section in its entirety with attached.

DRAWINGS

- ITEM NO. 5. DRAWING P0.1 – GENERAL NOTES, SYMBOLS, AND ABBREVIATIONS
- a. Revised verbiage on keynotes 022226, 022209, 221112, 221113, 221142, and 221143.
 - b. Replace sheet in its entirety with attached.

- ITEM NO. 6. DRAWING PD1.0 – LOWER LEVEL PLUMBING REMOVAL PLAN
- a. Revised verbiage on keynotes 022226 and 022209.
 - b. Replace sheet in its entirety with attached.

- ITEM NO. 7. DRAWING P1.1 – UNDERFLOOR PLUMBING PLAN LOWER LEVEL
- a. Revised location of keynote 221219.
 - b. Replace sheet in its entirety with attached.

- ITEM NO. 8. DRAWING P2.1 – LOWER LEVEL OVERALL PLUMBING PLAN
- a. Revised verbiage on keynotes 221113, 221142, and 221143.
 - b. Revised location of keynote 221113.
 - c. Replace sheet in its entirety with attached.

- ITEM NO. 9. DRAWING P4.1 – PLUMBING ENLARGED PLANS – LOWER LEVEL I
- a. Added keynote 221113 tag on 4/P4.1.
 - b. Revised verbiage keynote 221113.
 - c. Replace sheet in its entirety with attached.

- ITEM NO. 10. DRAWING M0.1 – GENERAL INFORMATION
- a. Added keynotes 230009 and 230011.
 - b. Replace sheet in its entirety with attached.

- ITEM NO. 11. DRAWING M1.2 – ROOF MECHANICAL DUCTWORK PLAN
- a. Added callout for enlarged plan 4/M4-2 of Mechanical Room 200.
 - b. Replace sheet in its entirety with attached.

- ITEM NO. 12. DRAWING M4.2 – MECHANICAL ROOMS ENLARGED PLANS
- a. Added enlarged plan 4/M-2 to sheet.
 - b. Added keynotes 230009 and 230011.
 - c. Replace sheet in its entirety with attached.

- ITEM NO. 13. DRAWING M5.3 – MECHANICAL DETAILS - III
- a. Edited details 1/M5-3 and 2/M5-3 to tag “Supply Fan Section”. Removed “Supply Fan Array Section”.
 - b. Replace sheet in its entirety with attached.
- ITEM NO. 14. DRAWING M6.1 – MECHANICAL EQUIPMENT SCHEDULES -1
- a. Added “Quantity” column to INDOOR AIR HANDLING UNIT SCHEDULE.
 - b. Replace sheet in its entirety with attached.

ATTACHMENTS:

PROJECT MANUAL – VOLUME 2

1. 122113 – HORIZONTAL LOUVER BLINDS
2. 123553.13 – METAL LABORATORY CASEWORK

PROJECT MANUAL – VOLUME 3

1. 211313 – WET-PIPE SPRINKLER SYSTEMS

DRAWINGS

1. P0.1 – GENERAL NOTES, SYMBOLS AND ABBREVIATIONS
2. PD1.0 – LOWER LEVEL PLUMBING REMOVAL PLAN
3. P1.1 – UNDERFLOOR PLUMBING PLAN LOWER LEVEL
4. P2.1 – LOWER LEVEL OVERALL PLUMBING PLAN
5. P4.1 – PLUMBING ENLARGED PLANS – LOWER LEVEL I
6. M0.1 – GENERAL INFORMATION
7. M1.2 – ROOF MECHANICAL DUCTWORK PLAN
8. M4.2 – MECHANICAL ROOMS ENLARGED PLANS
9. M5.3 – MECHANICAL DETAILS – III
10. M6.1 – MECHANICAL EQUIPMENT SCHEDULES - 1

END OF ADDENDUM NO. 04

SECTION 122113 - HORIZONTAL LOUVER BLINDS

PART 1 - GENERAL

1.1 RELATED DOCUMENTS

- A. Drawings and general provisions of the Contract, including General and Supplementary Conditions and Division 01 Specification Sections, apply to this Section.

1.2 SUMMARY

A. Section Includes:

- 1. Horizontal louver blinds with aluminum slats.

B. Related Requirements:

- 1. Section 061053 - "Miscellaneous Rough Carpentry" for wood blocking and grounds for mounting horizontal louver blinds and accessories.

1.3 ACTION SUBMITTALS

- A. Product Data: For each type of product.
- B. Shop Drawings: Show fabrication and installation details for horizontal louver blinds.
- C. Samples for Initial Selection: For each type and color of horizontal louver blind.
 - 1. Include similar Samples of accessories involving color selection.

1.4 INFORMATIONAL SUBMITTALS

- A. Product Certificates: For each type of horizontal louver blind.
- B. Product Test Reports: For each type of horizontal louver blind, for tests performed by manufacturer and witnessed by a qualified testing agency.

1.5 CLOSEOUT SUBMITTALS

- A. Maintenance Data: For horizontal louver blinds to include in maintenance manuals.

1.6 DELIVERY, STORAGE, AND HANDLING

- A. Deliver horizontal louver blinds in factory packages, marked with manufacturer, product name and location of installation using same designations indicated on Drawings.

1.7 FIELD CONDITIONS

- A. Environmental Limitations: Do not install horizontal louver blinds until construction and wet and finish work in spaces, including painting, is complete and dry and ambient temperature and humidity conditions are maintained at the levels indicated for Project when occupied for its intended use.
- B. Field Measurements: Where horizontal louver blinds are indicated to fit to other construction, verify dimensions of other construction by field measurements before fabrication and indicate measurements on Shop Drawings. Allow clearances for operating hardware of operable glazed units through entire operating range. Notify Architect of installation conditions that vary from Drawings. Coordinate fabrication schedule with construction progress to avoid delaying the Work.

PART 2 - PRODUCTS

2.1 MANUFACTURERS

- A. Source Limitations: Obtain horizontal louver blinds from single source from single manufacturer.

2.2 HORIZONTAL LOUVER BLINDS, ALUMINUM SLATS

- A. Manufacturers: Subject to compliance with requirements, provide products by one of the following manufacturers:
 - 1. Hunter Douglas Contract.
 - 2. Levolor Contract; a Newell Rubbermaid company.
 - 3. Springs Window Fashions.
- B. **Provide at the following locations:**
 - 1. **Office 110**
 - 2. **Office 113**
 - 3. **Office 118**
 - 4. **Office 119**
 - 5. **Office 121**

- C. Slats: Aluminum; alloy and temper recommended by producer for type of use and finish indicated; with crowned profile and radius corners.
1. Width: 1-inch.
 2. Thickness: Manufacturer's standard.
 3. Spacing: Manufacturer's standard.
 4. Finish: Ionized antistatic, dust-repellent, baked polyester finish.
 5. Lengths: Coordinate with window sizes and mullion spacing.
- D. Headrail: Formed steel or extruded aluminum; long edges returned or rolled. Headrails fully enclose operating mechanisms on three sides.
1. Capacity: One blind per headrail unless otherwise indicated.
 2. Ends: Manufacturer's standard.
 3. Manual Lift Mechanism:
 - a. Lift-Cord Lock: Variable; stops lift cord at user-selected position within blind full operating range.
 - b. Operator: Extension of lift cord(s) through lift-cord lock mechanism to form cord pull.
 4. Manual Tilt Mechanism: Enclosed worm-gear mechanism and linkage rod that adjusts ladders.
 - a. Tilt: Full.
 - b. Operator: Clear-plastic wand.
 - c. Over-Rotation Protection: Manufacturer's detachable operator or slip clutch to prevent over rotation of gear.
 5. Manual Lift-Operator and Tilt-Operator Lengths: Full length of blind when blind is fully closed except at transom windows.
 6. Manual Lift-Operator and Tilt-Operator Locations: Manufacturer's standard unless otherwise indicated.
 7. Integrated Headrail/Valance: Curved face.
- E. Bottom Rail: Formed-steel or extruded-aluminum tube that secures and protects ends of ladders and lift cords and has plastic- or metal-capped ends.
1. Type: Manufacturer's standard.
- F. Lift Cords: Manufacturer's standard braided cord.
- G. Ladders: Evenly spaced across headrail at spacing that prevents long-term slat sag.
1. Type: Braided cord.
- H. Valance: Manufacturer's standard.

- I. Mounting Brackets: With spacers and shims required for blind placement and alignment indicated.
 - 1. Type: End Mount.
 - 2. Intermediate Support: Provide intermediate support brackets to produce support spacing recommended by blind manufacturer for weight and size of blind.
- J. Colors, Textures, Patterns, and Gloss:
 - 1. Slats: As selected by Architect from manufacturer's full range.
 - 2. Components: Provide cords, ladders and materials exposed to view matching or coordinating with slat color unless otherwise indicated.

2.3 HORIZONTAL LOUVER BLIND FABRICATION

- A. Product Safety Standard: Fabricate horizontal louver blinds to comply with WCMA A 100.1 including requirements for corded, flexible, looped devices; lead content of components; and warning labels.
- B. Unit Sizes: Fabricate units in sizes to fill window and other openings as follows, measured at 74 deg F:
 - 1. Between (Inside) Jamb Installation: Width equal to jamb-to-jamb dimension of opening in which blind is installed less 1/4 inch per side or 1/2-inch total, plus or minus 1/8-inch. Length equal to head-to-sill dimension of opening in which blind is installed less 1/4-inch, plus or minus 1/8-inch.
- C. Concealed Components: Non-corrodible or corrosion-resistant-coated materials.
 - 1. Lift-and-Tilt Mechanisms: With permanently lubricated moving parts.
- D. Mounting and Intermediate Brackets: Designed for removal and reinstallation of blind without damaging blind and adjacent surfaces, for supporting blind components and for bracket positions and blind placement indicated.
- E. Installation Fasteners: No fewer than two fasteners per bracket, fabricated from metal noncorrosive to brackets and adjoining construction; type designed for securing to supporting substrate; and supporting blinds and accessories under conditions of normal use.
- F. Color-Coated Finish:
 - 1. Metal: For components exposed to view, apply manufacturer's standard baked finish complying with manufacturer's written instructions for surface preparation including pretreatment, application, baking and minimum dry film thickness.

PART 3 - EXECUTION

3.1 EXAMINATION

- A. Examine substrates, areas and conditions, with Installer present, for compliance with requirements for installation tolerances, operational clearances and other conditions affecting performance.
 - 1. Proceed with installation only after unsatisfactory conditions have been corrected.

3.2 INSTALLATION

- A. Install horizontal louver blinds at all exterior windows.
- B. Install horizontal louver blinds level and plumb, aligned and centered on openings and aligned with adjacent units according to manufacturer's written instructions.
 - 1. Locate so exterior slat edges are not closer 2-inches from interior faces of glass and not closer than 1-inch from interior faces of glazing frames through full operating ranges of blinds.
 - 2. Install mounting and intermediate brackets to prevent deflection of headrails.
 - 3. Install with clearances that prevent interference with adjacent blinds, adjacent construction and operating hardware of glazed openings, other window treatments and similar building components and furnishings.

3.3 ADJUSTING

- A. Adjust horizontal louver blinds to operate free of binding or malfunction through full operating ranges.

3.4 CLEANING AND PROTECTION

- A. Clean horizontal louver blind surfaces after installation according to manufacturer's written instructions.
- B. Provide final protection and maintain conditions in a manner acceptable to manufacturer and Installer and that ensures that horizontal louver blinds are without damage or deterioration at time of Substantial Completion.
- C. Replace damaged horizontal louver blinds that cannot be repaired in a manner approved by Architect before time of Substantial Completion.

END OF SECTION 122113

(THIS PAGE INTENTIONALLY LEFT BLANK)

SECTION 123553.13 - METAL LABORATORY CASEWORK

PART 1 - GENERAL

1.1 RELATED DOCUMENTS

- A. Drawings and general provisions of the Contract, including General and Supplementary Conditions and Division 01 Specification Sections, apply to this Section.

1.2 SUMMARY

- A. Section Includes:

- 1. Metal laboratory casework
- 2. Filler and closure panels.

- B. Related Requirements:

- 1. Section 061053 "Miscellaneous Rough Carpentry" for wood blocking for anchoring laboratory casework.
- 2. Section 092216 "Non-Structural Metal Framing" for reinforcements in metal-framed partitions for anchoring laboratory casework.
- 3. Section 096513 "Resilient Base and Accessories" for resilient base applied to metal laboratory casework.

1.3 PREINSTALLATION MEETINGS

- A. Preinstallation Conference: Conduct conference at Project site.

1.4 COORDINATION

- A. Coordinate layout and installation of framing and reinforcements for support of laboratory casework.
- B. Coordinate installation of laboratory casework with installation of fume hoods and other laboratory equipment.

1.5 ACTION SUBMITTALS

- A. Product Data: For each type of product.
- B. Shop Drawings: For laboratory casework. Include plans, elevations, sections and attachment details.

1. Indicate types and sizes of cabinets.
2. Indicate locations of hardware.
3. Indicate locations and types of service fittings.
4. Indicate locations of blocking and reinforcements required for installing laboratory casework.
5. Include details of utility spaces showing supports for conduits and piping.
6. Include details of support framing system.
7. Include details of exposed conduits, if required, for service fittings.
8. Indicate locations of and clearances from adjacent walls, doors, windows, other building components, and other laboratory equipment.
9. Include coordinated dimensions for laboratory equipment specified in other Sections.

C. Samples for Initial Selection: For factory-applied finishes and other materials requiring color selection.

D. Samples for Verification: For each type of cabinet finish and each type of countertop material, in manufacturer's standard sizes.

1.6 INFORMATIONAL SUBMITTALS

A. Qualification Data: For manufacturer.

B. Product Test Reports for Countertop Surface Material: Based on evaluation of comprehensive tests performed by a qualified testing agency, indicating compliance of laboratory countertop surface materials with requirements specified for chemical and physical resistance.

1.7 MAINTENANCE MATERIAL SUBMITTALS

A. Furnish complete touchup kit for each type and color of metal laboratory casework provided. Include fillers, primers, paints and other materials necessary to perform permanent repairs to damaged laboratory casework finish.

B. Furnish extra materials that match products installed and that are packaged with protective covering for storage and identified with labels describing contents.

1. Cabinet Mounting Clips and Related Hardware: Quantity equal to 5 percent of amount installed, but no fewer than 20 of each type.
2. Modular Countertop Units: Two extra units of each length and material installed.

1.8 QUALITY ASSURANCE

A. Manufacturer Qualifications: A qualified manufacturer that produces casework of types indicated for this Project that has been tested for compliance with SEFA 8 M.

1.9 DELIVERY, STORAGE AND HANDLING

- A. Protect finished surfaces during handling and installation with protective covering of polyethylene film or other suitable material.

1.10 FIELD CONDITIONS

- A. Environmental Limitations: Do not deliver or install laboratory casework until building is enclosed, utility roughing-in and wet work are complete and dry and temporary HVAC system is operating and maintaining temperature and relative humidity at occupancy levels during the remainder of the construction period.
- B. Locate concealed framing, blocking and reinforcements that support casework by field measurements before being enclosed and indicate measurements on Shop Drawings.

1.11 WARRANTY

- A. Warranty Period: One (1) year after Substantial Completion.

PART 2 - PRODUCTS

2.1 MANUFACTURERS

- A. Basis-of-Design Product: Subject to compliance with requirements, provide "HLF Steel Casework" as manufactured by Hanson Lab Furniture, Inc." or a comparable product by one of the following:
 - 1. Bedcolab Ltd.
 - 2. BMC Manufacturing.
 - 3. Kewaunee Scientific Corporation.
 - 4. Lab Crafters, Inc.
 - 5. Lab Fabricators.
 - 6. Mott Manufacturing Ltd.
 - 7. Airmaster System, Inc.
 - 8. Institutional Casework, Inc. (ICI Scientific)**
- B. Source Limitations: Obtain laboratory casework from single source from single manufacturer unless otherwise indicated.

2.2 PERFORMANCE REQUIREMENTS

- A. System Structural Performance: Laboratory casework and support framing system shall withstand the effects of the following gravity loads and stresses without permanent deformation, excessive deflection or binding of drawers and doors:
1. Wall Cabinets (Upper Cabinets): 160 lb/ft.
 2. Shelves: 40 lb/sq. ft.

2.3 CASEWORK, GENERAL

- A. Casework Product Standard: Comply with SEFA 8 M, "Laboratory Grade Metal Casework."
- B. Electrical Components, Devices and Accessories: Listed and labeled as defined in NFPA 70, by a qualified testing agency, and marked for intended location and application.

2.4 METAL CABINET MATERIALS

- A. Metal: Cold-rolled, commercial steel (CS) sheet, complying with ASTM A 1008/A 1008M; matte finish; suitable for exposed applications.
- B. Nominal Metal Thickness:
1. Sides, Ends, Fixed Backs, Bottoms, Tops, Soffits and Items Not Otherwise Indicated: 0.048-inch.
 2. Back Panels, Doors, Drawer Fronts and Bodies and Shelves: 0.036-inch except 0.048-inch for back panels and doors of flammable liquid storage cabinets and for unreinforced shelves more than 36-inches long.
 3. Intermediate Horizontal Rails, Table Aprons and Cross Rails, Center Posts and Top Gussets: 0.060-inch.
 4. Drawer Runners, Sink Supports and Hinge Reinforcements: 0.075-inch.
 5. Leveling and Corner Gussets: 0.105-inch.

2.5 METAL CABINETS

- A. Fabrication: Assemble and finish units at point of manufacture. Use precision dies for interchangeability of like-size drawers, doors and similar parts. Perform assembly on precision jigs to provide units that are square. Reinforce units with angles, gussets and channels. Except where otherwise specified, integrally frame and weld cabinet bodies to form dirt- and vermin-resistant enclosures. Where applicable, reinforce base cabinets for sink support. Maintain uniform clearance around door and drawer fronts of 1/16 to 3/32-inch.
- B. Flush Doors: Outer and inner pans that nest into box formation, with full-height channel reinforcements at center of door. Fill doors with noncombustible, sound-deadening material.
- C. Hinged Doors: Mortise for hinges and reinforce with angles welded inside inner pans at hinge edge.

- D. Drawers: Fronts made from outer and inner pans that nest into box formation, with no raw metal edges at top. Sides, back, and bottom fabricated in one piece with rolled or formed top of sides for stiffening and comfortable grasp for drawer removal. Provide drawers with rubber bumpers, polymer roller slides and positive stops to prevent metal-to-metal contact or accidental removal.
- E. Adjustable Shelves: Front, back and ends formed down, with edges returned horizontally at front and back to form reinforcing channels.
- F. Toe Space: Fully enclosed, 4-inches high by 3-inches deep, with no open gaps or pockets.
- G. Filler and Closure Panels: Provide where indicated and as needed to close spaces between cabinets and walls, ceilings and indicated equipment. Fabricate from same material and with same finish as cabinets and with hemmed or flanged edges unless otherwise indicated.

2.6 METAL CABINET FINISH

- A. General: Prepare, treat, and finish welded assemblies after assembling. Prepare, treat, and finish components that are to be assembled with mechanical fasteners before assembling. Prepare, treat and finish concealed surfaces same as exposed surfaces.
- B. Preparation: After assembly, clean surfaces of mill scale, rust, oil and other contaminants. After cleaning, apply a conversion coating suited to the organic coating to be applied over it.
- C. Chemical-Resistant Finish: Immediately after cleaning and pretreating, apply laboratory casework manufacturer's standard two-coat, chemical-resistant, baked-on finish consisting of prime coat and thermosetting topcoat. Comply with coating manufacturer's written instructions for applying and baking to achieve a minimum dry film thickness of 2 mils.
 - 1. Chemical and Physical Resistance of Finish System: Finish complies with acceptance levels of cabinet surface finish tests in SEFA 8 M. Acceptance level for chemical spot test shall be no more than four Level 3 conditions.
 - 2. Colors for Metal Laboratory Casework Finish: As selected by Architect from manufacturer's full range.

2.7 HARDWARE

- A. General: Provide laboratory casework manufacturer's standard, commercial-quality, heavy-duty hardware complying with requirements indicated for each type.
- B. Hinges: Stainless-steel, five-knuckle hinges complying with BHMA A156.9, Grade 1, with antifriction bearings and rounded tips. Provide two for doors 48 inches high or less and three for doors more than 48-inches high.

- C. Hinged Door and Drawer Pulls: Solid-aluminum, stainless-steel or chrome-plated-brass, back-mounted pulls. Provide two pulls for drawers more than 24-inches wide.
 - 1. Design: Wire pulls rectangular loop pulls with rounded corners.
 - 2. Overall Size: 1 by 4-1/2-inches.
- D. Door Catches: Nylon-roller spring catches. Provide two catches on doors more than 48-inches high.
- E. Drawer Slides: Side mounted, epoxy-coated steel, self-closing; designed to prevent rebound when drawers are closed; complying with BHMA A156.9, Type B05091.
 - 1. Standard Duty (Grade 1): Full-extension type, with polymer rollers.
- F. Locks: Cam or half-mortise type with five-pin tumbler, brass with chrome-plated finish; complying with BHMA A156.11, Type E0728 in all drawers and cabinets.
- G. Sliding-Door Hardware Sets: Laboratory casework manufacturer's standard, to suit type and size of sliding-door units.

PART 3 - EXECUTION

3.1 EXAMINATION

- A. Examine areas, with Installer present, for compliance with requirements for installation tolerances, location of reinforcements and other conditions affecting performance of the Work.
- B. Proceed with installation only after unsatisfactory conditions have been corrected.

3.2 INSTALLATION OF CABINETS

- A. Comply with installation requirements in SEFA 2.3. Install level, plumb, and true; shim as required, using concealed shims. Where laboratory casework abuts other finished work, apply filler strips and scribe for accurate fit, with fasteners concealed where practical. Do not exceed the following tolerances:
 - 1. Variation of Tops of Base Cabinets from Level: 1/16-inch in 10 feet.
 - 2. Variation of Bottoms of Upper Cabinets from Level: 1/8-inch in 10 feet.
 - 3. Variation of Faces of Cabinets from a True Plane: 1/8-inch in 10 feet.
 - 4. Variation of Adjacent Surfaces from a True Plane (Lippage): 1/32-inch.
 - 5. Variation in Alignment of Adjacent Door and Drawer Edges: 1/16-inch.
- B. Utility-Space Framing: Secure to floor with two fasteners at each frame. Fasten to partition framing, wood blocking or metal reinforcements in partitions and to base cabinets.

- C. Base Cabinets: Fasten cabinets to utility-space framing, partition framing, wood blocking or reinforcements in partitions, with fasteners spaced not more than 16-inches o.c. Bolt adjacent cabinets together with joints flush, tight, and uniform.
 - 1. Where base cabinets are installed away from walls, fasten to floor at toe space at not more than 24-inches o.c. and at sides of cabinets with not less than two fasteners per side.
- D. Wall Cabinets: Fasten to hanging strips, masonry, partition framing, blocking, or reinforcements in partitions. Fasten each cabinet through back, near top, at not less than 16-inches o.c.
- E. Install hardware uniformly and precisely. Set hinges snug and flat in mortises.
- F. Adjust laboratory casework and hardware so doors and drawers align and operate smoothly without warp or bind and contact points meet accurately. Lubricate operating hardware as recommended by manufacturer.
- G. Remove excess sealant or adhesive while still wet and finish joint for neat appearance.

3.3 CLEANING AND PROTECTING

- A. Clean finished surfaces, touch up as required, and remove or refinish damaged or soiled areas to match original factory finish, as approved by Architect.

END OF SECTION 123553.13

(THIS PAGE INTENTIONALLY LEFT BLANK)

SECTION 211313 - WET-PIPE SPRINKLER SYSTEMS

PART 1 - GENERAL

1.1 RELATED DOCUMENTS

- A. Drawings and general provisions of the Contract, including General and Supplementary Conditions and Division 01 Specification Sections, apply to this Section.

1.2 SUMMARY

- A. Section Includes:
 - 1. Pipes, fittings, and specialties.
 - 2. Cover system for sprinkler piping.
 - 3. Specialty valves.
 - 4. Sprinklers.
 - 5. Alarm devices.
 - 6. Pressure gauges.
- B. Related Requirements:
 - 1. Section 210523 "General-Duty Valves for Water-Based Fire-Suppression Piping" for ball, butterfly, check, gate, post-indicator, and trim and drain valves.

1.3 DEFINITIONS

- A. Standard-Pressure Sprinkler Piping: Wet-pipe sprinkler system piping designed to operate at working pressure of 175-psig maximum.

1.4 ACTION SUBMITTALS

- A. Product Data: For each type of product.
 - 1. Include rated capacities, operating characteristics, electrical characteristics, and furnished specialties and accessories.
- B. Shop Drawings: For wet-pipe sprinkler systems.
 - 1. Include plans, elevations, sections, and attachment details.
 - 2. Include diagrams for power, signal, and control wiring.
- C. Delegated-Design Submittal: For wet-pipe sprinkler systems indicated to comply with performance requirements and design criteria, including analysis data signed and sealed by the qualified professional engineer responsible for their preparation.

1.5 INFORMATIONAL SUBMITTALS

- A. Coordination Drawings: Sprinkler systems, or BIM model, drawn to scale, on which the following items are shown and coordinated with each other, using input from installers of the items involved:
 - a. Domestic water piping.
 - b. HVAC hydronic piping.
 - c. Items penetrating finished ceiling include the following:
 - 1) Lighting fixtures.
 - 2) Air outlets and inlets.
- B. Qualification Data: For qualified Installer and professional engineer.
- C. Design Data:
 - 1. Approved Sprinkler Piping Drawings: Working plans, prepared according to NFPA 13, that have been approved by authorities having jurisdiction, including hydraulic calculations if applicable.
- D. Welding certificates.
- E. Field Test Reports:
 - 1. Indicate and interpret test results for compliance with performance requirements and as described in NFPA 13. Include "Contractor's Material and Test Certificate for Aboveground Piping."
 - 2. Fire-hydrant flow test report.
- F. Field quality-control reports.

1.6 CLOSEOUT SUBMITTALS

- A. Operation and Maintenance Data: For wet-pipe sprinkler systems and specialties to include in emergency, operation, and maintenance manuals.

1.7 MAINTENANCE MATERIAL SUBMITTALS

- A. Furnish extra materials that match products installed and that are packaged with protective covering for storage and identified with labels describing contents.
 - 1. Sprinkler Cabinets: Finished, wall-mounted, steel cabinet with hinged cover, and with space for minimum of six spare sprinklers plus sprinkler wrench. Include number of sprinklers required by NFPA 13 and sprinkler wrench. Include separate cabinet with sprinklers and wrench for each type of sprinkler used on Project.

1.8 QUALITY ASSURANCE

A. Installer Qualifications:

1. Installer's responsibilities include designing, fabricating, and installing sprinkler systems and providing professional engineering services needed to assume engineering responsibility. Base calculations on results of fire-hydrant flow test.
 - a. Engineering Responsibility: Preparation of working plans, calculations, and field test reports by a qualified professional engineer.

B. Welding Qualifications: Qualify procedures and operators according to 2010 ASME Boiler and Pressure Vessel Code.

PART 2 - PRODUCTS

2.1 PERFORMANCE REQUIREMENTS

- A. Electrical Components, Devices, and Accessories: Listed and labeled as defined in NFPA 70, by a qualified testing agency, and marked for intended location and application.
- B. Sprinkler system equipment, specialties, accessories, installation, and testing shall comply with NFPA 13.
- C. Standard-Pressure Piping System Component: Listed for 175-psig minimum working pressure.
- D. Delegated Design: Engage a qualified professional engineer, as defined in Section 014000 "Quality Requirements," to design wet-pipe sprinkler systems.
 1. Available fire-hydrant flow test records indicated on sheet FP0.1.
 2. Sprinkler system design shall be approved by authorities having jurisdiction.
 - a. Margin of Safety for Available Water Flow and Pressure: 10 percent, including losses through water-service piping, valves, and backflow preventers.
 - b. Sprinkler Occupancy Hazard Classifications:
 - 1) Automobile Parking Areas: Ordinary Hazard, Group 1.
 - 2) Building Service Areas: Ordinary Hazard, Group 1.
 - 3) Electrical Equipment Rooms: Ordinary Hazard, Group 1.
 - 4) General Storage Areas: Ordinary Hazard, Group 1.
 - 5) Mechanical Equipment Rooms: Ordinary Hazard, Group 1.
 - 6) Office and Public Areas: Light Hazard.
 3. Minimum Density for Automatic-Sprinkler Piping Design:
 - a. Light-Hazard Occupancy: 0.10 gpm over 1500-sq. ft. area.
 - b. Ordinary-Hazard, Group 1 Occupancy: 0.15 gpm over 1500-sq. ft. area.
 - c. Ordinary-Hazard, Group 2 Occupancy: 0.20 gpm over 1500-sq. ft. area.

- d. Special Occupancy Hazard: As determined by authorities having jurisdiction.
- 4. Maximum Protection Area per Sprinkler:
 - a. Office Spaces: 225 sq. ft..
 - b. Storage Areas: 130 sq. ft..
 - c. Mechanical Equipment Rooms: 130 sq. ft..
 - d. Electrical Equipment Rooms: 130 sq. ft..
 - e. Other Areas: According to NFPA 13 recommendations unless otherwise indicated.

2.2 STEEL PIPE AND FITTINGS

- A. Standard-Weight, Black-Steel Pipe: ASTM A53/A53M, Type E. Pipe ends may be factory or field formed to match joining method.
- B. Black-Steel Pipe Nipples: ASTM A733, made of ASTM A53/A53M, standard-weight, seamless steel pipe with threaded ends.
- C. Uncoated-Steel Couplings: ASTM A865/A865M, threaded.
- D. Uncoated, Gray-Iron Threaded Fittings: ASME B16.4, Class 125, standard pattern.
- E. Malleable- or Ductile-Iron Unions: UL 860.
- F. Cast-Iron Flanges: ASME 16.1, Class 125.
- G. Grooved-Joint, Steel-Pipe Appurtenances:
 - 1. Manufacturers: Subject to compliance with requirements, provide products by one of the following:
 - a. Anvil International.
 - b. Tyco by Johnson Controls Company.
 - c. Victaulic Company.
 - 2. Pressure Rating: 175-psig minimum.
 - 3. Uncoated Grooved-End Fittings for Steel Piping: ASTM A47/A47M, malleable-iron casting or ASTM A536, ductile-iron casting, with dimensions matching steel pipe.
 - 4. Grooved-End-Pipe Couplings for Steel Piping: AWWA C606 and UL 213 rigid pattern, unless otherwise indicated, for steel-pipe dimensions. Include ferrous housing sections, EPDM-rubber gasket, and bolts and nuts.

2.3 COVER SYSTEM FOR SPRINKLER PIPING

- A. Manufacturers: Subject to compliance with requirements, provide products by the following:
 - 1. DecoShield Systems, Inc.
 - 2. JG Innovations, Inc.
- B. Description: System of support brackets and covers made to protect sprinkler piping.

- C. Brackets: Glass-reinforced nylon.
- D. Covers: Galvanized Steel, 16 gauge.

2.4 SPECIALTY VALVES

- A. Listed in UL's "Fire Protection Equipment Directory" or FM Global's "Approval Guide."
- B. Pressure Rating:
 - 1. Standard-Pressure Piping Specialty Valves: 175-psig minimum.
- C. Body Material: Cast or ductile iron.
- D. Size: Same as connected piping.
- E. End Connections: Flanged or grooved.
- F. Alarm Valves:
 - 1. Manufacturers: Subject to compliance with requirements, provide products by one of the following:
 - a. Globe Fire Sprinkler Corporation.
 - b. Reliable Automatic Sprinkler Co., Inc. (The).
 - c. Tyco by Johnson Controls Company.
 - d. Venus Fire Protection Ltd.
 - e. Victaulic Company.
 - f. Viking Corporation.
 - 2. Standard: UL 193.
 - 3. Design: For horizontal or vertical installation.
 - 4. Include trim sets for bypass, drain, electrical sprinkler alarm switch, pressure gauges, and fill-line attachment with strainer.
 - 5. Drip cup assembly pipe drain with check valve to main drain piping.
 - 6. Electrical Components, Devices, and Accessories: Listed and labeled as defined in NFPA 70, by a qualified testing agency, and marked for intended location and application.
- G. Deluge Valves:
 - 1. Manufacturers: Subject to compliance with requirements, provide products by one of the following:
 - a. Globe Fire Sprinkler Corporation.
 - b. Reliable Automatic Sprinkler Co., Inc. (The).
 - c. Tyco by Johnson Controls Company.
 - d. Victaulic Company.
 - e. Viking Corporation.

2. Standard: UL 260.
3. Design: Hydraulically operated, differential-pressure type.
4. Include trim sets for alarm-test bypass, drain, electrical water-flow alarm switch, pressure gauges, drip cup assembly piped without valves and separate from main drain line, and fill-line attachment with strainer.
5. Wet, Pilot-Line Trim Set: Include gauge to read diaphragm-chamber pressure and manual control station for manual operation of deluge valve, and connection for actuation device.

H. Automatic (Ball Drip) Drain Valves:

1. Manufacturers: Subject to compliance with requirements, provide products by one of the following:
 - a. Reliable Automatic Sprinkler Co., Inc. (The).
 - b. Tyco by Johnson Controls Company.
2. Standard: UL 1726.
3. Pressure Rating: 175-psig minimum.
4. Type: Automatic draining, ball check.
5. Size: NPS 3/4.
6. End Connections: Threaded.

2.5 AIR VENT

A. Automatic Air Vent:

1. Description: Automatic air vent that automatically vents trapped air without human intervention.
2. Standard: UL listed or FM Global approved for use in wet-pipe fire sprinkler systems.
3. Vents oxygen continuously from system.
4. Float valve to prevent water discharge.
5. Minimum Water Working Pressure Rating: 175 psig.

2.6 SPRINKLER PIPING SPECIALTIES

A. Branch Outlet Fittings:

1. Manufacturers: Subject to compliance with requirements, provide products by one of the following:
 - a. AGF Manufacturing, Inc.
 - b. Anvil International.
 - c. National Fittings, Inc.
 - d. Shurjoint; a part of Aalberts Integrated piping Systems.
 - e. Tyco by Johnson Controls Company.
 - f. Victaulic Company.
2. Standard: UL 213.
3. Pressure Rating: 175-psig minimum.

4. Body Material: Ductile-iron housing with EPDM seals and bolts and nuts.
 5. Type: Mechanical-tee and -cross fittings.
 6. Configurations: Snap-on and strapless, ductile-iron housing with branch outlets.
 7. Size: Of dimension to fit onto sprinkler main and with outlet connections as required to match connected branch piping.
 8. Branch Outlets: Grooved, plain-end pipe, or threaded.
- B. Flow Detection and Test Assemblies:
1. Manufacturers: Subject to compliance with requirements, provide products by one of the following:
 - a. AGF Manufacturing, Inc.
 - b. Reliable Automatic Sprinkler Co., Inc. (The).
 - c. Tyco by Johnson Controls Company.
 - d. Victaulic Company.
 2. Standard: UL's "Fire Protection Equipment Directory" or FM Global's "Approval Guide."
 3. Pressure Rating: 175-psig minimum.
 4. Body Material: Cast- or ductile-iron housing with orifice, sight glass, and integral test valve.
 5. Size: Same as connected piping.
 6. Inlet and Outlet: Threaded or grooved.
- C. Sprinkler Inspector's Test Fittings:
1. Manufacturers: Subject to compliance with requirements, provide products by one of the following:
 - a. AGF Manufacturing, Inc.
 - b. Triple R Specialty.
 - c. Tyco by Johnson Controls Company.
 - d. Victaulic Company.
 - e. Viking Corporation.
 2. Standard: UL's "Fire Protection Equipment Directory" or FM Global's "Approval Guide."
 3. Pressure Rating: 175-psig minimum.
 4. Body Material: Cast- or ductile-iron housing with sight glass.
 5. Size: Same as connected piping.
 6. Inlet and Outlet: Threaded.
- D. Adjustable Drop Nipples:
1. Manufacturers: Subject to compliance with requirements, provide products by one of the following:
 - a. Aegis Technologies, Inc.
 - b. CECA, LLC.
 - c. CPS Products, Inc.
 - d. Merit Manufacturing.
 2. Standard: UL 1474.

3. Pressure Rating: 250-psig minimum.
4. Body Material: Steel pipe with EPDM-rubber O-ring seals.
5. Size: Same as connected piping.
6. Length: Adjustable.
7. Inlet and Outlet: Threaded.

E. Flexible Sprinkler Hose Fittings:

1. Manufacturers: Subject to compliance with requirements, provide products by one of the following:
 - a. ALEUM USA.
 - b. FlexHead Industries, Inc.
 - c. Gateway Tubing, Inc.
 - d. Victaulic Company.
2. Standard: UL 1474.
3. Type: Flexible hose for connection to sprinkler, and with bracket for connection to ceiling grid.
4. Pressure Rating: 175-psig minimum.
5. Size: Same as connected piping, for sprinkler.

2.7 SPRINKLERS

- A. Manufacturers: Subject to compliance with requirements, provide products by one of the following:
1. Globe Fire Sprinkler Corporation.
 2. Reliable Automatic Sprinkler Co., Inc. (The).
 3. Tyco by Johnson Controls Company.
 4. Victaulic Company.
 5. Viking Corporation.
- B. Listed in UL's "Fire Protection Equipment Directory" or FM Global's "Approval Guide."
- C. Pressure Rating for Automatic Sprinklers: 175-psig minimum.
- D. Automatic Sprinklers with Heat-Responsive Element:
1. Nonresidential Applications: UL 199.
 2. Characteristics: Nominal 1/2-inch orifice with Discharge Coefficient K of 5.6, and for "Ordinary" temperature classification rating unless otherwise indicated or required by application.
- E. Sprinkler Finishes: Chrome plated.
- F. Sprinkler Escutcheons: Materials, types, and finishes for the following sprinkler mounting applications. Escutcheons for concealed, flush, and recessed-type sprinklers are specified with sprinklers.

1. Ceiling Mounting: Chrome-plated steel, one piece, flat.
2. Sidewall Mounting: Chrome-plated steel, one piece, flat.

G. Sprinkler Guards:

1. Manufacturers: Subject to compliance with requirements, provide products by one of the following:
 - a. Reliable Automatic Sprinkler Co., Inc. (The).
 - b. Tyco by Johnson Controls Company.
 - c. Victaulic Company.
 - d. Viking Corporation.
2. Standard: UL 199.
3. Type: Wire cage with fastening device for attaching to sprinkler.

2.8 ALARM DEVICES

A. Alarm-device types shall match piping and equipment connections.

B. Electrically Operated Notification Appliances:

1. Manufacturers: Subject to compliance with requirements, provide products by one of the following:
 - a. Fire-Lite Alarms; Honeywell International, Inc.
 - b. Notifier; Honeywell International, Inc.
 - c. Potter Electric Signal Company, LLC.
2. Electric Bell:
 - a. Standard: UL 464.
 - b. Type: Vibrating, metal alarm bell.
 - c. Size: 6-inch minimum- diameter.
 - d. Electrical Components, Devices, and Accessories: Listed and labeled as defined in NFPA 70, by a qualified testing agency, and marked for intended location and application.
 - e. Finish: Red-enamel or polyester powder-coat factory finish, suitable for outdoor use with approved and listed weatherproof backbox.
3. Strobe/Horn:
 - a. Standard: UL 464.
 - b. Tone: Selectable, steady, Temporal-3 (T-3) in accordance with ISO 8201 and ANSI/ASA S3.41, 2400 Hz, electromechanical, broadband.
 - c. Voltage: 120 V ac, 60 Hz.
 - d. Effective Intensity: 110 cd.
 - e. Finish: Red, suitable for outdoor use with approved and listed weatherproof backbox. White letters on housing identifying device as for "Fire."

- f. Sign, Integrated: Mount between backbox and strobe/horn with text visible on both sides, above and below strobe/horn. Housing to be shaped to cover surface-mounted weatherproof backbox. Sign is to consist of white lettering on red plastic identifying it as a "Sprinkler Fire Alarm" and instructing viewers to call 911, police, or fire department.

C. Water-Flow Indicators:

1. Manufacturers: Subject to compliance with requirements, provide products by one of the following:
 - a. ADT Security Services, Inc.
 - b. McDonnell & Miller.
 - c. Potter Electric Signal Company, LLC.
 - d. System Sensor.
 - e. Viking Corporation.
 - f. WATTS.
2. Standard: UL 346.
3. Water-Flow Detector: Electrically supervised.
4. Components: Two single-pole, double-throw circuit switches for isolated alarm and auxiliary contacts, 7 A, 125-V ac and 0.25 A, 24-V dc; complete with factory-set, field-adjustable retard element to prevent false signals and tamperproof cover that sends signal if removed.
5. Type: Paddle operated.
6. Pressure Rating: 250 psig.
7. Design Installation: Horizontal or vertical.

D. Pressure Switches:

1. Manufacturers: Subject to compliance with requirements, provide products by one of the following:
 - a. Barksdale, Inc.
 - b. Detroit Switch, Inc.
 - c. Potter Electric Signal Company, LLC.
 - d. System Sensor.
 - e. Tyco by Johnson Controls Company.
 - f. United Electric Controls Co.
 - g. Viking Corporation.
2. Standard: UL 346.
3. Type: Electrically supervised water-flow switch with retard feature.
4. Components: Single-pole, double-throw switch with normally closed contacts.
5. Design Operation: Rising pressure signals water flow.

E. Valve Supervisory Switches:

1. Manufacturers: Subject to compliance with requirements, provide products by one of the following:
 - a. Fire-Lite Alarms; Honeywell International, Inc.
 - b. Kennedy Valve Company; a division of McWane, Inc.
 - c. Potter Electric Signal Company, LLC.
 - d. System Sensor.
2. Standard: UL 346.

3. Type: Electrically supervised.
4. Components: Single-pole, double-throw switch with normally closed contacts.
5. Design: Signals that controlled valve is in other than fully open position.
6. Electrical Components, Devices, and Accessories: Listed and labeled as defined in NFPA 70, by a qualified testing agency, and marked for intended location and application.

2.9 PRESSURE GAUGES

- A. Manufacturers: Subject to compliance with requirements, provide products by one of the following:
 1. AGF Manufacturing, Inc.
 2. AMETEK, Inc.
 3. Ashcroft Inc.
 4. Brecco Corporation.
 5. WIKA Instrument Corporation.
- B. Standard: UL 393.
- C. Dial Size: 3-1/2- to 4-1/2-inch diameter.
- D. Pressure Gauge Range: 0- to 250-psig minimum.
- E. Label: Include "WATER" label on dial face.

PART 3 - EXECUTION

3.1 PREPARATION

- A. Perform fire-hydrant flow test according to NFPA 13 and NFPA 291. Use results for system design calculations required in "Quality Assurance" Article.
- B. Report test results promptly and in writing.

3.2 PIPING INSTALLATION

- A. Locations and Arrangements: Drawing plans, schematics, and diagrams indicate general location and arrangement of piping. Install piping as indicated on approved working plans.

1. Deviations from approved working plans for piping require written approval from authorities having jurisdiction. File written approval with Architect before deviating from approved working plans.
 2. Coordinate layout and installation of sprinklers with other construction that penetrates ceilings, including light fixtures, HVAC equipment, and partition assemblies.
- B. Piping Standard: Comply with NFPA 13 requirements for installation of sprinkler piping.
- C. Use listed fittings to make changes in direction, branch takeoffs from mains, and reductions in pipe sizes.
- D. Install unions adjacent to each valve in pipes NPS 2 and smaller.
- E. Install flanges, flange adapters, or couplings for grooved-end piping on valves, apparatus, and equipment having NPS 2-1/2 and larger end connections.
- F. Install "Inspector's Test Connections" in sprinkler system piping, complete with shutoff valve, and sized and located according to NFPA 13.
- G. Install sprinkler piping with drains for complete system drainage.
- H. Install sprinkler control valves, test assemblies, and drain risers adjacent to standpipes when sprinkler piping is connected to standpipes.
- I. Install automatic (ball drip) drain valve at each check valve for fire-department connection, to drain piping between fire-department connection and check valve. Install drain piping to and spill over floor drain or to outside building.
- J. Install alarm devices in piping systems.
- K. Install hangers and supports for sprinkler system piping according to NFPA 13. Comply with requirements for hanger materials in NFPA 13. In seismic-rated areas, refer to Section 210548 "Vibration and Seismic Controls for Fire-Suppression Piping and Equipment."
- L. Install pressure gauges on riser or feed main, at each sprinkler test connection, and at top of each standpipe. Include pressure gauges with connection not less than NPS 1/4 and with soft-metal seated globe valve, arranged for draining pipe between gauge and valve. Install gauges to permit removal, and install where they are not subject to freezing.
- M. Pressurize and check preaction sprinkler system piping and air compressors.
- N. Fill sprinkler system piping with water.
- O. Install sleeves for piping penetrations of walls, ceilings, and floors. Comply with requirements for sleeves specified in Section 210517 "Sleeves and Sleeve Seals for Fire-Suppression Piping."
- P. Install sleeve seals for piping penetrations of concrete walls and slabs. Comply with requirements for sleeve seals specified in Section 210517 "Sleeves and Sleeve Seals for Fire-Suppression Piping."

- Q. Install escutcheons for piping penetrations of walls, ceilings, and floors. Comply with requirements for escutcheons specified in Section 210518 "Escutcheons for Fire-Suppression Piping."
- R. All required shut-off valves in the housing units will be clearly marked, located in the same place in each chase, and accessible without a ladder.
- S. Shut-off valves located above the ceiling shall be within 36" of the ceiling.
- T. Refer to Section 135500 "Prefabricated Modular Steel Cells" for fire protection requirements for the prefabricated steel cells.
- U. Division 21 Contractor required to coordinate with the Prefabricated Modular Steel Cell layouts and manufacturer so piping and location of sprinkler head are accounted for by the manufacturer. See section 3.13 of this specification for sprinkler heads.
- V. The Detention Cell Manufacturer shall provide piping and a prepared location in the Prefabricated Modular Steel Cell ceilings for installation of the sprinkler head. Piping shall be a straight section with no intermediate fittings.
 - 1. The sprinkler head shall be provided, installed and tested by fire protection contractor.
 - 2. Connection of the cell fire protection piping to the fire protection system shall be made at the mechanical chase by the fire protection contractor.

3.3 JOINT CONSTRUCTION

- A. Install couplings, flanges, flanged fittings, unions, nipples, and transition and special fittings that have finish and pressure ratings same as or higher than system's pressure rating for aboveground applications unless otherwise indicated.
- B. Install unions adjacent to each valve in pipes NPS 2 and smaller.
- C. Install flanges, flange adapters, or couplings for grooved-end piping on valves, apparatus, and equipment having NPS 2-1/2 and larger end connections.
- D. Ream ends of pipes and tubes and remove burrs. Bevel plain ends of steel pipe.
- E. Remove scale, slag, dirt, and debris from inside and outside of pipes, tubes, and fittings before assembly.
- F. Flanged Joints: Select appropriate gasket material in size, type, and thickness suitable for water service. Join flanges with gasket and bolts according to ASME B31.9.
- G. Threaded Joints: Thread pipe with tapered pipe threads according to ASME B1.20.1. Cut threads full and clean using sharp dies. Ream threaded pipe ends to remove burrs and restore full ID. Join pipe fittings and valves as follows:
 - 1. Apply appropriate tape or thread compound to external pipe threads.

2. Damaged Threads: Do not use pipe or pipe fittings with threads that are corroded or damaged.
- H. Steel-Piping, Roll-Grooved Joints: Roll rounded-edge groove in end of pipe according to AWWA C606. Assemble coupling with housing, gasket, lubricant, and bolts. Join steel pipe and grooved-end fittings according to AWWA C606 for steel-pipe grooved joints.
 - I. Dissimilar-Material Piping Joints: Make joints using adapters compatible with materials of both piping systems.
- 3.4 INSTALLATION OF COVER SYSTEM FOR SPRINKLER PIPING
- A. Install cover system, brackets, and cover components for sprinkler piping according to manufacturer's "Installation Manual" and NFPA 13 or NFPA 13R for supports.
- 3.5 VALVE AND SPECIALTIES INSTALLATION
- A. Install listed fire-protection valves, trim and drain valves, specialty valves and trim, controls, and specialties according to NFPA 13 and authorities having jurisdiction.
 - B. Install listed fire-protection shutoff valves supervised open, located to control sources of water supply except from fire-department connections. Install permanent identification signs indicating portion of system controlled by each valve.
 - C. Install check valve in each water-supply connection. Install backflow preventers instead of check valves in potable-water-supply sources.
 - D. Specialty Valves:
 1. Install valves in vertical position for proper direction of flow, in main supply to system.
 2. Install alarm valves with bypass check valve and retarding chamber drain-line connection.
 3. Install deluge valves in vertical position, in proper direction of flow, and in main supply to deluge system. Install trim sets for drain, priming level, alarm connections, ball drip valves, pressure gauges, priming chamber attachment, and fill-line attachment.
 - E. Air Vent:
 1. Provide at least one air vent at high point in each wet-pipe sprinkler system in accordance with NFPA 13 requirements. Connect vent into top of fire sprinkler piping.
 2. Provide dielectric union for dissimilar metals, ball valve, and strainer upstream of automatic air vent.
- 3.6 SPRINKLER INSTALLATION
- A. Install sprinklers in suspended ceilings in center of narrow dimension of acoustical ceiling panels.

- B. Install dry-type sprinklers with water supply from heated space. Do not install pendent or sidewall, wet-type sprinklers in areas subject to freezing.
- C. Install sprinklers into flexible, sprinkler hose fittings, and install hose into bracket on ceiling grid.

3.7 IDENTIFICATION

- A. Install labeling and pipe markers on equipment and piping according to requirements in NFPA 13.
- B. Identify system components, wiring, cabling, and terminals. Comply with requirements for identification specified in Section 260553 "Identification for Electrical Systems."

3.8 FIELD QUALITY CONTROL

- A. Perform the following tests and inspections with the assistance of a factory-authorized service representative:
 1. Leak Test: After installation, charge systems and test for leaks. Repair leaks and retest until no leaks exist.
 2. Test and adjust controls and safeties. Replace damaged and malfunctioning controls and equipment.
 3. Flush, test, and inspect sprinkler systems according to NFPA 13, "Systems Acceptance" Chapter.
 4. Energize circuits to electrical equipment and devices.
 5. Coordinate with fire-alarm tests. Operate as required.
 6. Verify that equipment hose threads are same as local fire department equipment.
- B. Sprinkler piping system will be considered defective if it does not pass tests and inspections.
- C. Prepare test and inspection reports.

3.9 CLEANING

- A. Clean dirt and debris from sprinklers.
- B. Only sprinklers with their original factory finish are acceptable. Remove and replace any sprinklers that are painted or have any other finish than their original factory finish.

3.10 DEMONSTRATION

- A. Engage a factory-authorized service representative to train Owner's maintenance personnel to adjust, operate, and maintain specialty valves.

3.11 PIPING SCHEDULE

- A. Piping between Fire Department Connections and Check Valves: Galvanized, standard-weight steel pipe with grooved ends, grooved-end fittings, grooved-end-pipe couplings, and grooved joints.
- B. Sprinkler specialty fittings may be used, downstream of control valves, instead of specified fittings.
- C. Standard-pressure, wet-pipe sprinkler system, NPS 2 and smaller, shall be the following:
 - 1. Standard-weight, black-steel pipe with threaded ends; uncoated, gray-iron threaded fittings; and threaded joints.
 - 2. Standard-weight, black-steel pipe with roll-grooved ends; uncoated, grooved-end fittings for steel piping; grooved-end-pipe couplings for steel piping; and grooved joints.
- D. Standard-pressure, wet-pipe sprinkler system, NPS 2-1/2 to NPS 4, shall be the following:
 - 1. Standard-weight, black-steel pipe with threaded ends; uncoated, gray-iron threaded fittings; and threaded joints.
 - 2. Standard-weight, black-steel pipe with roll-grooved ends; uncoated, grooved-end fittings for steel piping; grooved-end-pipe couplings for steel piping; and grooved joints.
- E. Standard-pressure, wet-pipe sprinkler system, NPS 5 and larger, shall be the following:
 - 1. Standard-weight, black-steel pipe with threaded ends; uncoated, gray-iron threaded fittings; and threaded joints.
 - 2. Standard-weight, black-steel pipe with roll-grooved ends; uncoated, grooved-end fittings for steel piping; grooved-end-pipe couplings for steel piping; and grooved joints.

3.12 SPRINKLER SCHEDULE

- A. Use sprinkler types in subparagraphs below for the following applications:
 - 1. Rooms without Ceilings: Upright sprinklers.
 - 2. Rooms with Suspended Ceilings: non-security area: Recessed, quick response sprinklers.
 - 3. Rooms with Suspended Ceilings, Inmate Occupied Area with non-security ceiling (excluding dayrooms): Concealed sprinklers.
 - 4. Wall Mounting: Sidewall sprinklers.
 - 5. Spaces Subject to Freezing: Upright, quick response sprinklers.
 - 6. Deluge-Sprinkler Systems: Upright, open, quick response sprinklers.
- B. Provide sprinkler types in subparagraphs below with finishes indicated.
 - 1. Concealed Sprinklers: Rough brass, with factory-painted white cover plate.
 - 2. Recessed Sprinklers: Bright chrome, with bright chrome escutcheon.

3. Upright, Pendent, and Sidewall Sprinklers: Chrome plated in finished spaces exposed to view; rough bronze in unfinished spaces not exposed to view; wax coated where exposed to acids, chemicals, or other corrosive fumes.

END OF SECTION 211313

THIS PAGE INTENTIONALLY LEFT BLANK

NOTE:
NOT EVERY KEYNOTE IS APPLICABLE TO EVERY
SHEET

PLUMBING KEYNOTES - MASTER INDEX

Table with 2 columns: Keynote ID and Description. Includes notes like 'DOMESTIC EXISTING PIPING SERVING FLOOR ABOVE', 'EXISTING PIPING UP TO OUTSIDE HOSE BIBB', and 'REMOVE ALL EXISTING DOMESTIC PLUMBING PIPING AND FIXTURES BEYOND THIS POINT FOR ROUTING OF NEW LINES TO FIXTURES'.

PLUMBING KEYNOTES - MASTER INDEX

Table with 2 columns: Keynote ID and Description. Includes notes like 'EXISTING DOMESTIC AND SANITARY LINES SERVING MOP SINK AND EWC ABOVE', 'EXISTING DOMESTIC AND SANITARY LINES SERVING EWC ABOVE', and 'PROVIDE 2 1/2" SCW, 1 1/2" DWH, 1" DWHR FOR INFRASTRUCTURE ROUGH-IN ALTERNATE TO SERVICE FUTURE RENOVATED RESTROOM ABOVE'.


PLUMBING BASIS OF DESIGN

Table with 3 columns: Category, Value, and Unit. Includes rows for SANITARY (419 DFLS), COLD WATER (700 WSFU'S), HOT WATER (106 WSFU'S), and GAS (5320 CFH).

PLUMBING SYMBOLS

Table of plumbing symbols and their corresponding descriptions. Includes symbols for compressed air, domestic cold water, domestic soft cold water, natural gas, domestic hot water, domestic hot water (140), hot water return, sanitary above ground, sanitary below ground, storm above ground, storm below ground, above ground vent, below ground vent, ball valve, calibrated balancing valve, check valve, single line - pipe drop, single line - pipe rise, single line - pipe rise tee, single line - pipe drop tee, two line - pipe drop, two line - pipe rise, roof drain, overflow roof drain, water hammer arrestor, connect to existing, and demo to point.

ANNOTATION SYMBOLS

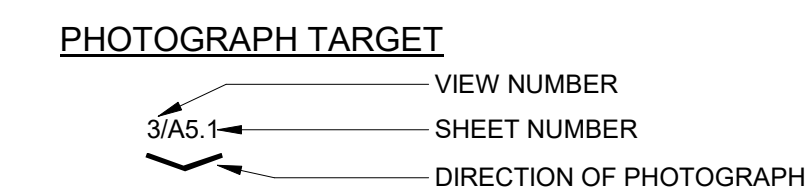

EQUIPMENT ABBREVIATIONS

Table of equipment abbreviations and their full names. Includes AD (AREA DRAIN), CB (CATCH BASIN), CU (COMBINATION UNIT), DF (DRINKING FOUNTAIN), EWC (ELECTRIC WATER COOLER), FCO (FLOOR CLEAN OUT), FD (FLOOR DRAIN), GDS (GARBAGE DISPOSAL GREASE INTERCEPTOR), HB (HOSE BIBB), IMB (ICE MACHINE BOX), LI (LAVATORY LINT INTERCEPTOR), MB (MOP BASIN), OI (OIL INTERCEPTOR), RD (ROOF DRAIN), RCP (REGULATING PUMP), SH (SHOWER), S (SINK), TD (TRAP DRAIN), TP (TRAP PRIMER), TV (TEMPERING VALVE), URV (URINAL), WH (WALL HYDRANT), WC (WATER CLOSET), WCO (WALL CLEANOUT), WH (WATER HEATER), WHA (WATER HAMMER ARRESTOR), WS (WATER SOFTENER), WDET (DOMESTIC EXPANSION TANK), WD (WATER DISPOSAL), IMB (ICE MACHINE BOX), WHA (WATER HAMMER ARRESTOR).

PLUMBING ABBREVIATIONS

Table of plumbing abbreviations and their full names. Includes AFF (ABOVE FINISHED FLOOR), AFG (ABOVE FINISHED GRADE), BT (BRINE TANK), BV (BALANCING VALVE), CONT (CONTINUATION), CN (CORN), DN (DOWN), DWG. (DRAWING), ELEV. (ELEVATION), FBG (FROM BELOW GRADE), FFA (FROM FLOOR ABOVE), FFB (FROM FLOOR BELOW), FUT (FUTURE), G (NATURAL GAS), GPM (GALLONS PER MINUTE), HW (HOT WATER), HWR (HOT WATER RETURN), IE (INVERT ELEVATION), IK (LAVATORY KITCHEN), W (WASTE), MAX (MAXIMUM), MIN (MINIMUM), OS&Y (OUTSIDE SCREW & YOKE), PHE (PLATE HEAT EXCHANGER), ST (STORM), SQFT (SQUARE FEET), TBSI (TO BELOW GRADE), TFA (TO FLOOR ABOVE), TFB (TO FLOOR BELOW), TS (TEMPERATURE SENSOR), TYP (TYPICAL), V (VENT), VTR (VENT THROUGH ROOF), W (WASTE).

GENERAL NOTES

- 1. INSTALLATION OF PLUMBING FIXTURES AND ACCESSORIES, INCLUDING FLUSH CONTROL VALVES INTENDED FOR PEOPLE WITH DISABILITIES, SHALL BE IN ACCORDANCE WITH ADA REQUIREMENTS.
- 2. INSTALLATION OF PLUMBING PIPING SHALL BE FULLY COORDINATED WITH STRUCTURAL, ARCHITECTURAL, ELECTRICAL, AND HVAC DRAWINGS TO AVOID CONFLICT.
- 3. NO PLUMBING (WATER, DRAINS, VENT, OR GAS PIPING) SHALL BE INSTALLED DIRECTLY ABOVE ANY ELECTRICAL PANELS. COORDINATE WITH OTHER DIVISIONS BEFORE PROCEEDING WITH INSTALLATION.
- 4. IF NON DESIGN BASE EQUIPMENT IS SELECTED, CONTRACTOR SHALL BEAR ADDITIONAL COSTS FOR MODIFICATIONS TO THE ORIGINAL SYSTEM(S), INCLUDING COSTS FOR ARCHITECT/ENGINEER DESIGN REVIEW.
- 5. PROVIDE WATER HAMMER ARRESTERS AT PLUMBING FIXTURES AND GROUPS OF PLUMBING FIXTURES THAT ARE SUBJECT TO WATER HAMMER. SELECT ARRESTERS IN ACCORDANCE WITH THE PLUMBING AND DRAINAGE INSTITUTE STANDARD.
- 6. CONTRACTOR SHALL FURNISH AND INSTALL ALL MATERIALS, LABOR AND EQUIPMENT PERMIT FEES, REQUIRED FOR, OR INCIDENTAL, TO THE INSTALLATION OF A COMPLETE AND OPERATIONAL PLUMBING SYSTEM AS INDICATED IN THE CONTRACT DOCUMENTS INCLUDING SPECIFICATIONS.
- 7. ALL PLUMBING SERVICES GOING INTO THE BUILDING AND LEAVING THE BUILDING SHALL BE CONNECTED TO THE SITE UTILITIES. COORDINATE WITH SITE UTILITIES DRAWINGS. COORDINATE ALL EXTERIOR UNDERGROUND PLUMBING WORK WITH THE SITE UTILITIES BEFORE COMMENCING WORK. COORDINATE ALL UNDERGROUND PIPING WITH FOUNDATION DRAWINGS.
- 8. ALL PLUMBING WORK SHALL BE IN CONFORMANCE WITH THE INTERNATIONAL PLUMBING CODE, LATEST EDITION ADOPTED BY THE STATE OF INDIANA WITH INDIANA AMENDMENTS, MUNICIPAL OR CITY CODES, AND THE AUTHORITY HAVING JURISDICTION.
- 9. INSTALL BALL VALVE CLOSE TO WATER MAIN ON EACH BRANCH AND RISER SERVING PLUMBING EQUIPMENT AND FIXTURES.
- 10. ALL REQUIRED SHUT-OFF VALVES IN THE HOUSING UNITS SHALL BE CLEARLY MARKED, LOCATED IN THE SAME PLACE, AND ACCESSIBLE WITHOUT A LADDER. SHUT-OFF VALVES LOCATED ABOVE THE CEILING THROUGHOUT THE BUILDING SHALL BE WITHIN 24" OF THE CEILING.
- 11. REFERENCE SECTIONS AND RISER / ISOMETRICS FOR ADDITIONAL INFORMATION ON PIPE SIZES NOT SHOWN IN PLAN VIEWS.
- 12. PIPING SERVING DRINKING FOUNTAINS, ELECTRIC WATER COOLERS, AND LAVATORIES LOCATED BELOW GRADE OR BELOW THE SECOND FLOOR SHALL BE SOFT COPPER TUBE AND INSTALLED IN 4" PVC CONDUIT WITH LONG SWEEP BENDS. CONDUIT TO BE CAPPED 12" ABOVE CHASE FLOOR AND CONCEALED BEHIND FIXTURES. INSTALLATION REQUIRED FOR FUTURE SERVICABILITY OR PIPE REPLACEMENT.
- 13. REFER TO ARCHITECTURAL ROOF DRAWINGS FOR DIMENSIONS.
- 14. CONTRACTOR SHALL PROVIDE ACCESS DOORS IN ALL WALLS AND CEILINGS WHERE SERVICE OR ADJUSTMENT TO MECHANICAL, PLUMBING, OR FIRE PROTECTION ITEMS MAY BE REQUIRED. ACCESS DOORS SHALL BE OF AN APPROPRIATE SIZE REQUIRED FOR EACH APPLICATION. WHERE APPLICABLE, ACCESS DOORS SHALL MATCH THE FIRE RATING OF THE WALL ASSEMBLY.
- 15. PROVIDE SIZES TO FIXTURES AS INDICATED ON PLANS, RISERS, AND SECTIONS. IF SIZE IS NOT INDICATED, PROVIDE SIZE SHOWN ON PLUMBING FIXTURE SCHEDULE.
- 16. PROVIDE HOUSEKEEPING PAD FOR EQUIPMENT. PAD SIZES SHOWN ARE APPROXIMATE AND ARE BASED ON BASIS OF DESIGN EQUIPMENT. MAINTENANCE REQUIREMENTS EQUIPMENT PADS SIZED TO SPECIFIC EQUIPMENT FURNISHED. PROVIDE EQUIPMENT PAD SIZES BASED ON ACTUAL SIZE OF FURNISHED EQUIPMENT. SUBMIT COORDINATION DRAWINGS ILLUSTRATING PROPOSED PAD DIMENSIONS BASED ON APPROVED EQUIPMENT. DO NOT PERFORM LAYOUT WORK OR BEGIN FORM WORK FOR PADS PRIOR TO APPROVAL OF COORDINATION DRAWINGS.
- 17. INITIAL FLOW TEST PERFORMED ON 02/07/2022 IS OUTDATED. CONTRACTOR TO VERIFY FLOW TEST PRIOR TO CONSTRUCTION AND REPORT BACK TO ENGINEER.

GENERAL DEMOLITION NOTES

- 1. REFER TO DRAWINGS OF ALL OTHER DISCIPLINES FOR ADDITIONAL REMOVALS AND SELECTIVE DEMOLITION ACTIVITIES.
- 2. CONTRACTOR SHALL FIELD VERIFY ALL EXISTING CONDITIONS AND DIMENSIONS PRIOR TO SELECTIVE DEMOLITION ACTIVITIES. ANY ITEMS NOT INDICATED ON DRAWINGS OR SPECIFICATIONS THAT ARE IN CONFLICT WITH THE CONTRACT WORK SHALL BE BROUGHT TO THE ATTENTION OF THE ARCHITECT PRIOR TO BID FOR CLARIFICATION.
- 3. FOR DURATION OF THE PROJECT IF ANY EXISTING ITEM IS DAMAGED DURING CONSTRUCTION, IT SHALL BE REPLACED AND RESTORED TO ITS ORIGINAL CONDITION AT NO ADDITIONAL COST TO THE OWNER.
- 4. CONTRACTOR IS RESPONSIBLE TO PROVIDE ALL TEMPORARY SHORING AND BRACING REQUIRED TO COMPLETE THE WORK.
- 5. CONTRACTOR IS RESPONSIBLE FOR ALL CUTTING AND PATCHING REQUIRED, INCLUDING ASSOCIATED REPAIR AND FINISHING TO MATCH ADJACENT SURFACES.
- 6. CONTRACTOR IS RESPONSIBLE FOR ALL TEMPORARY ENVIRONMENTAL CONTROL MEASURES INCLUDING ACCEPTABLE AIR QUALITY CONTROL MEASURES, DUST CONTROL, EROSION CONTROL AND OTHER MEASURES REQUIRED FOR PROTECTION OF PROPERTY DURING SELECTIVE DEMOLITION AND CONSTRUCTION ACTIVITIES.
- 7. CONTRACTOR IS SOLELY RESPONSIBLE FOR COORDINATING CONTRACT DRAWINGS WITH FIELD CONDITIONS AND WORK ASSOCIATED WITH EACH TRADE.
- 8. CONTRACTOR SHALL COORDINATE DEMOLITION ACTIVITIES WITH NEW WORK TO VERIFY DIMENSIONS AND EXTENT OF REMOVALS PRIOR TO BEGINNING OF WORK.
- 9. CONTRACTOR IS RESPONSIBLE FOR REMOVAL, STORAGE AND REINSTALLATION OF REMAINING WALL MOUNTED DEVICES INTENDED FOR REUSE.
- 10. ALL DEMOLITION WORK SHALL BE PERFORMED IN STRICT ACCORDANCE WITH ALL APPLICABLE SECTIONS OF THE STATE OF INDIANA, LOCAL BUILDING CODES, OSHA AND NFPA.
- 11. OWNER RESERVES THE RIGHT TO SALVAGE ANY EQUIPMENT OR MATERIAL INDICATED TO BE DEMOLISHED.
- 12. PIPING AND DUCTWORK DEMOLITION PLANS ARE FOR DIAGRAMMATIC PURPOSES ONLY BASED ON LIMITED SITE OBSERVATIONS. CONTRACTOR TO REMOVE ANY UNUSED / ABANDONED DUCTWORK, EQUIPMENT, PIPING (SANITARY VENT, DOMESTIC WATER, GAS, REFRIGERANT, FIRE ETC.), ASSOCIATED ACCESSORIES COMPLETE WHETHER INDICATED ON THE PLANS OR NOT. CONTRACTOR TO VERIFY EXTENT OF DEMOLITION ON THE FIELD AND COORDINATE WITH THE ENGINEER (AT NO ADDITIONAL COST TO THE OWNER). PATCH WALLS, CEILING, ROOF AND/OR FLOOR TO MATCH ADJACENT CONDITIONS WHETHER INDICATED ON THE PLANS OR NOT.


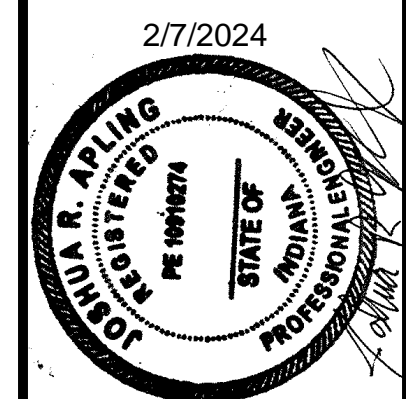


Table with columns: DATE, REVISION, NO., DRAWN, CHECK, DESIGNED, APPROVED, DATE. Includes revision history for 'ADDENDUM 1' and 'ADDENDUM 2'.

HANCOCK COUNTY BOARD OF COMMISSIONERS
OFFICE RENOVATIONS
123 E. MAIN STREET
GENERAL NOTES, SYMBOLS, AND ABBREVIATIONS
PROJECT NUMBER: 2163-1063-90

DRAWING NUMBER
P0.1
PLUMBING

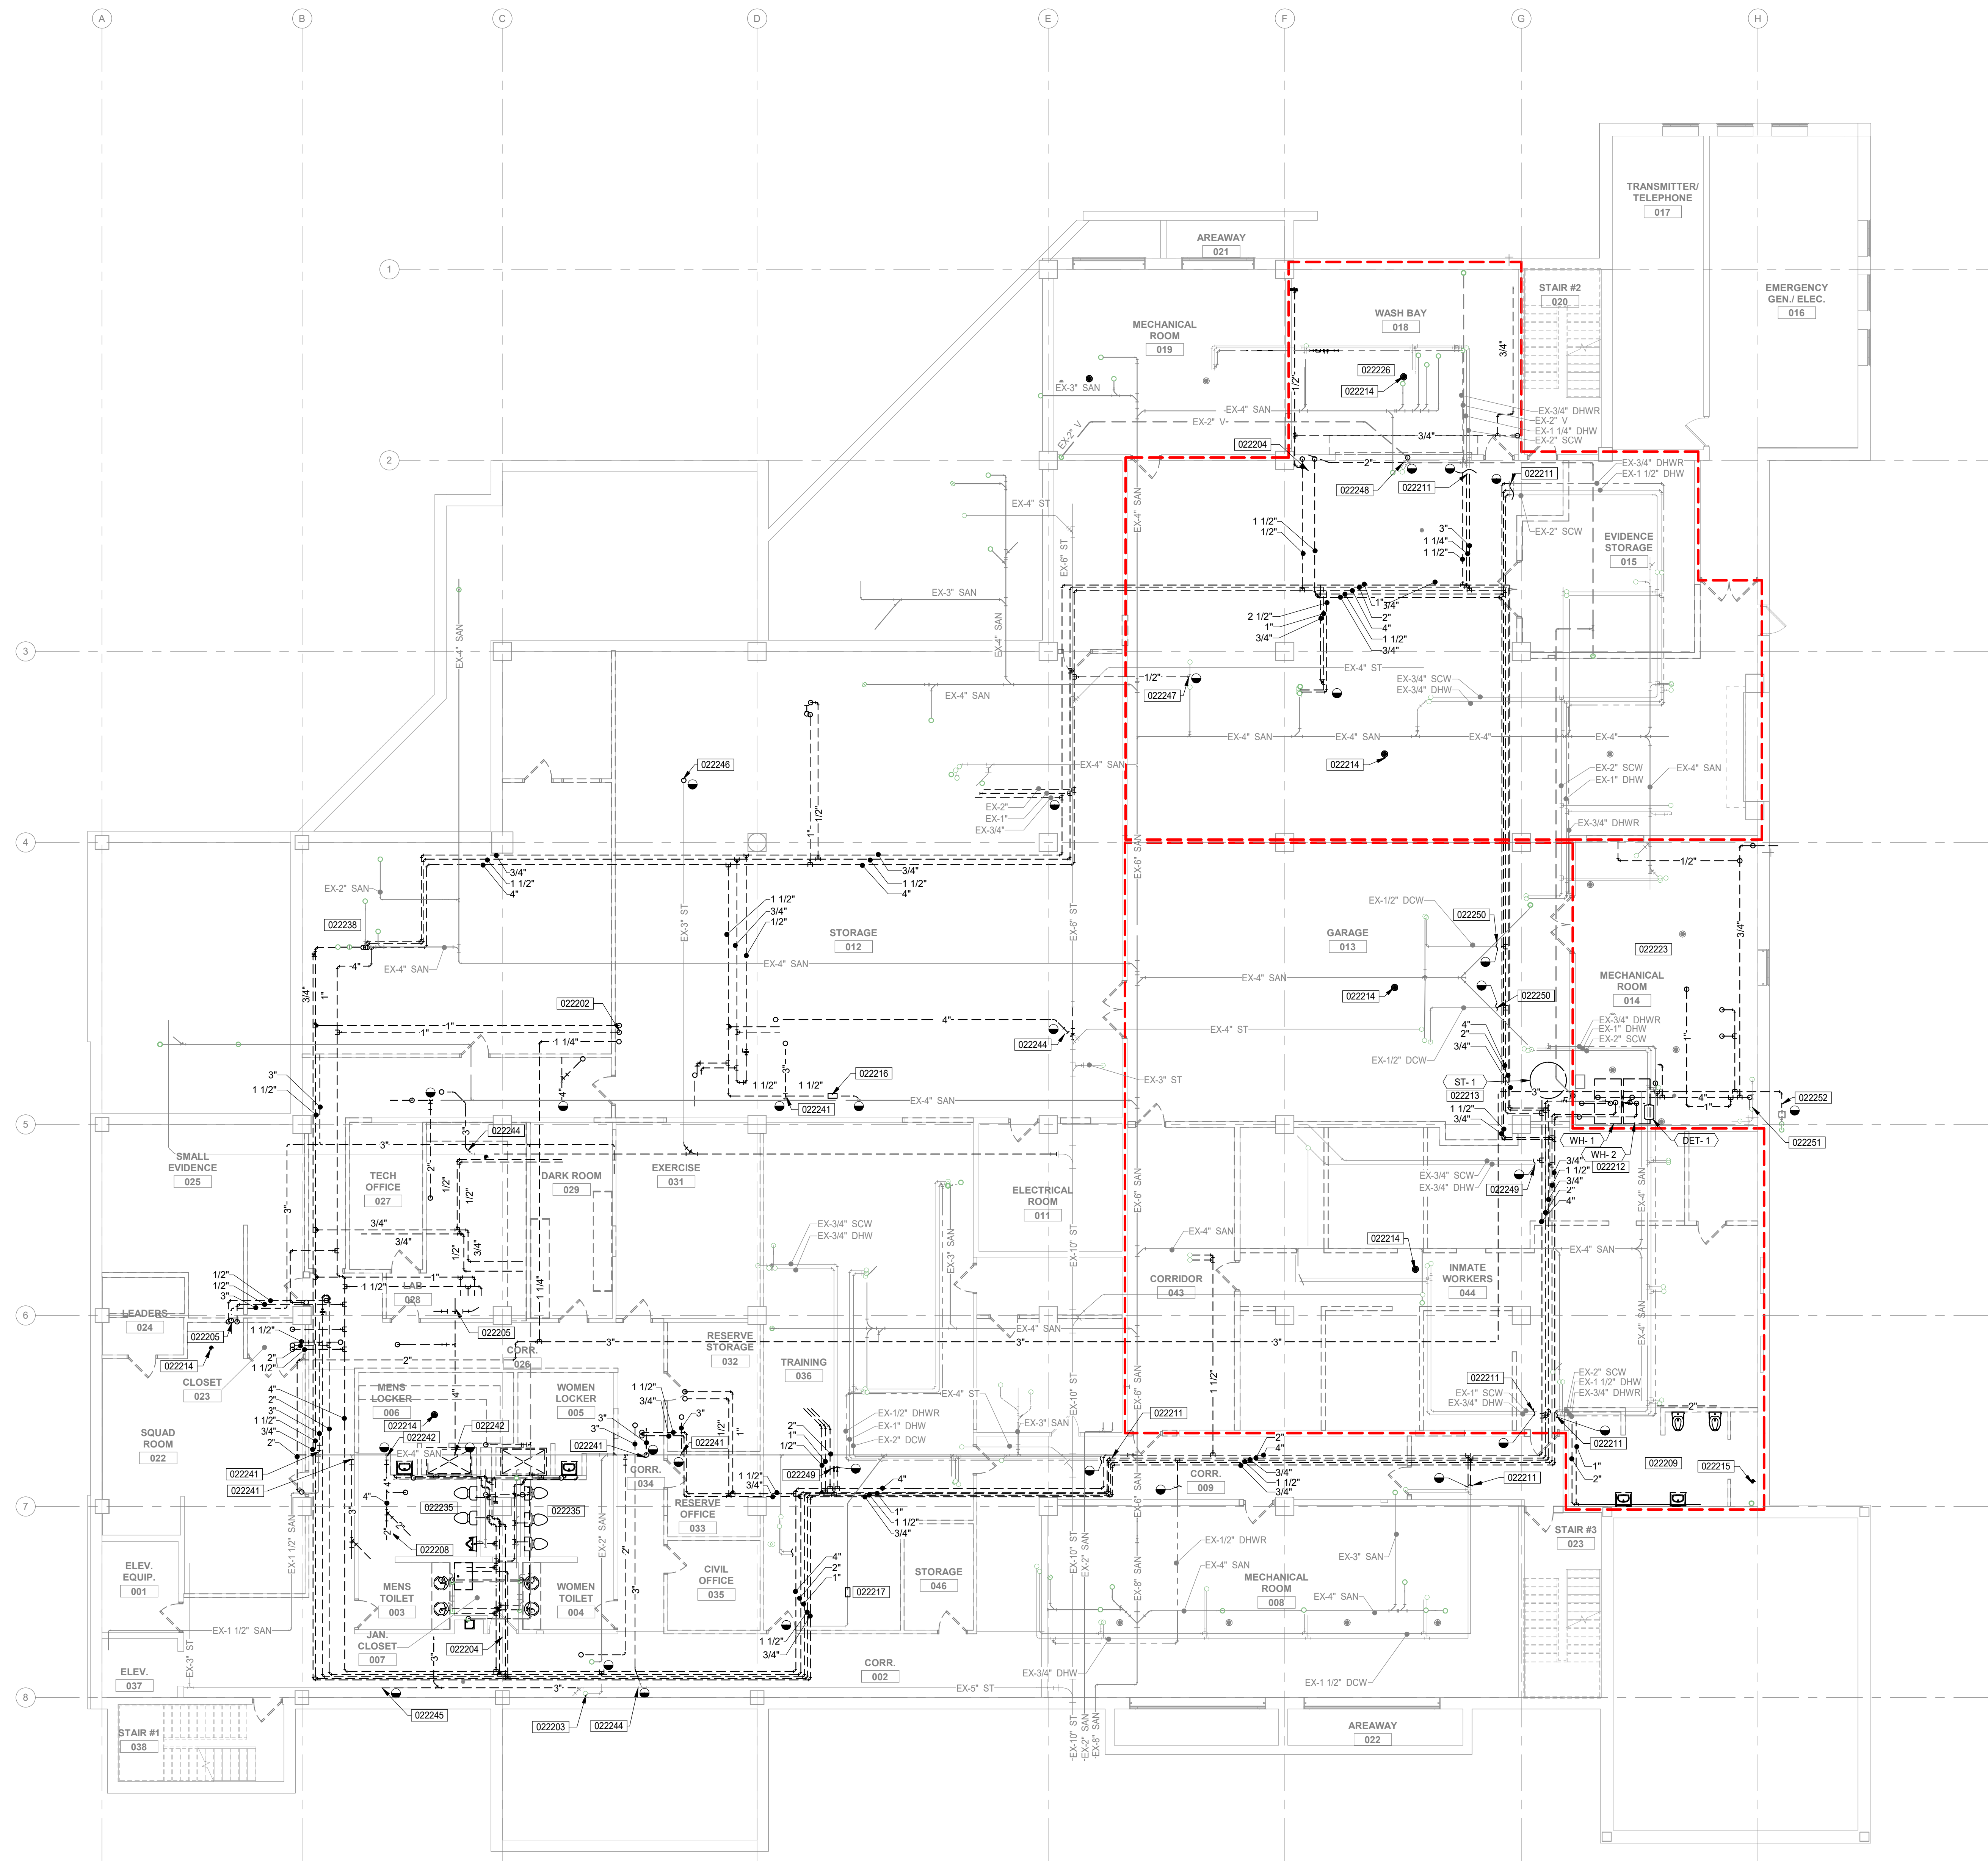


- ### GENERAL NOTES
- A. REFER TO SHEETS G1.1 AND P0.1 FOR ADDITIONAL GENERAL NOTES AND INFORMATION.
 - B. WHERE PIPE SIZE MAY NOT BE INDICATED SERVING A FIXTURE, PROVIDE SIZES AS INDICATED IN THE PLUMBING FIXTURE SCHEDULE.
 - C. INSTALL ALL EQUIPMENT, FIXTURES, AND ASSOCIATED ACCESSORIES PER MANUFACTURER RECOMMENDATIONS.
 - D. COORDINATE WITH ALL OTHER DISCIPLINES BEFORE INSTALLING ANY PIPING DEVICES.
 - E. INVERT ELEVATIONS ARE BASED ON 100.00' FINISHED FIRST FLOOR ELEVATION TO BOTTOM OF PIPE. SITE / CIVIL PLANS ESTABLISH FINISHED FLOOR ELEVATION.
 - F. PROVIDE GAS PRESSURE REGULATORS AS NEEDED FOR EQUIPMENT.
 - G. EXACT LOCATION OF PLUMBING FIXTURES SHALL BE COORDINATED WITH THE ARCHITECTURAL PLANS TO MEET A.D.A. REQUIREMENTS.

- ### PLUMBING KEYNOTES
- 022202 DOMESTIC EXISTING PIPING SERVING FLOOR ABOVE.
 - 022203 EXISTING PIPING UP TO OUTSIDE HOSE BIB.
 - 022204 REMOVE ALL EXISTING DOMESTIC PLUMBING PIPING AND FIXTURES BEYOND THIS POINT FOR ROUTING OF NEW LINES TO FIXTURES.
 - 022205 COMPLETELY REMOVE EXISTING SANITARY AND DOMESTIC PIPING.
 - 022208 REMOVE ALL EXISTING DOMESTIC AND SANITARY PIPING FOR ON FIRST FLOOR (UTP).
 - 022209 IF PUBLIC DEFENDER'S OFFICE ALTERNATE IS NOT ACCEPTED, RESTROOM PIPING AND FIXTURES SHALL REMAIN OPERATIONAL TILL FUTURE RENOVATION.
 - 022211 DOMESTIC PIPING SERVING CELLS ON FLOOR ABOVE TO REMAIN.
 - 022212 REMOVE EXISTING WATER HEATERS
 - 022213 REMOVE EXISTING HOT WATER STORAGE TANK
 - 022214 REMOVE EXISTING FLOOR DRAIN AND CAP SANITARY PIPING.
 - 022215 REMOVE EXISTING FLOOR CLEANOUT AND CAP SANITARY PIPING.
 - 022216 EXISTING FLUSH VALVE TO BE REMOVED WITH PIPING.
 - 022217 EXISTING FLUSH VALVE TO BE REMOVED AND REPLACED WITH WILLOUGHBY MODEL RFVB OR EQUAL DURING CONSTRUCTION.
 - 022223 REMOVE ALL PIPING BEYOND WATER ENTRANCE AND PLUMBING EQUIPMENT FROM ROOM. EASY WATER EXISTING TO BE REMOVED IN RENOVATION.
 - 022226 IF CORONER'S OFFICE ALTERNATE IS NOT ACCEPTED FLOOR DRAIN TO REMAIN.
 - 022235 REMOVE PLUMBING FIXTURES ASSOCIATED WITH DEMOLISHED PIPING. PATCH WALL/FLOOR TO MATCH ADJACENT CONDITIONS.
 - 022238 EXISTING SANITARY TO RESTROOM ABOVE TO REMAIN FOR NEW FIXTURE. DOMESTIC PIPES TO BE REMOVED FOR NEW PIPING INSTALLATION.
 - 022241 DISCONNECT AND REMOVE 3" SANITARY PIPING FROM 4" EXISTING MAIN.
 - 022242 DISCONNECT AND REMOVE 4" SANITARY PIPING FROM 4" EXISTING MAIN.
 - 022244 DISCONNECT AND REMOVE STORM PIPING UP TO POINT INDICATED.
 - 022245 STORM PIPING BEYOND THIS POINT TO REMAIN FOR USE IN RENOVATION.
 - 022246 DISCONNECT AND REMOVE 3" STORM PIPING BEYOND THIS POINT AND UP TO POINT SPECIFIED ON SHEET PD1.1.
 - 022247 DISCONNECT AND REMOVE EXISTING DCW SERVING EWC UP TO POINT INDICATED.
 - 022248 DISCONNECT AND REMOVE 2" VENT PIPING BEYOND POINT INDICATED.
 - 022249 DISCONNECT DCW AND DWH PIPING FROM MAIN FOR RECONNECTION TO NEW MAIN.
 - 022250 DISCONNECT DCW PIPING FROM MAIN FOR RECONNECTION TO NEW MAIN.
 - 022251 EXISTING WATER ENTRANCE AND BACK FLOW PREVENTER TO REMAIN.
 - 022252 DISCONNECT AND REMOVE ALL GAS PIPING BEYOND GAS METER.

--- ALTERNATE BOUNDARY AS NOTED/LABELLED

NOTE:
ELEMENTS ON THIS DRAWING ARE IDENTIFIED BY VARIOUS COLORS; IF THIS NOTE IS NOT RED, THIS DRAWING IS NOT IN COLOR AND NEEDS TO BE REPRINTED IN COLOR.

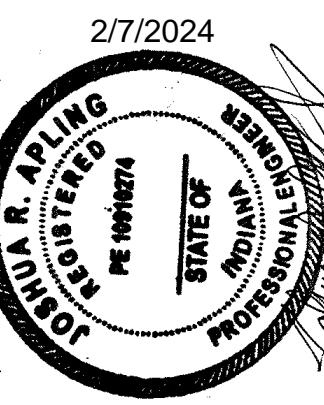

DATE	REVISION
2/7/24	2 - ADDENDUM 4

NO.	DATE	BY	CHKD.	APPV.
1	12/21/2023	JRA	JRA	JRA

PROJECT NUMBER: 2163-1063-90

HANCOCK COUNTY BOARD OF COMMISSIONERS
OFFICE RENOVATIONS
123 E. MAIN STREET
LOWER LEVEL PLUMBING REMOVAL PLAN

DRAWING NUMBER
PD1.0
PLUMBING



GENERAL NOTES



- A. REFER TO SHEETS G1.1 AND P0.1 FOR ADDITIONAL GENERAL NOTES AND INFORMATION.
- B. WHERE PIPE SIZE MAY NOT BE INDICATED SERVING A FIXTURE, PROVIDE SIZES AS INDICATED IN THE PLUMBING FIXTURE SCHEDULE.
- C. INSTALL ALL EQUIPMENT, FIXTURES, AND ASSOCIATED ACCESSORIES PER MANUFACTURER RECOMMENDATIONS.
- D. COORDINATE WITH ALL OTHER DISCIPLINES BEFORE INSTALLING ANY PIPING DEVICES.
- E. INVERT ELEVATIONS ARE BASED ON 100.00' FINISHED FIRST FLOOR ELEVATION TO BOTTOM OF PIPE. SITE / CIVIL PLANS ESTABLISH FINISHED FLOOR ELEVATION.
- F. PROVIDE GAS PRESSURE REGULATORS AS NEEDED FOR EQUIPMENT.
- G. EXACT LOCATION OF PLUMBING FIXTURES SHALL BE COORDINATED WITH THE ARCHITECTURAL PLANS TO MEET A.D.A. REQUIREMENTS.

PLUMBING KEYNOTES

- 221140 CONNECT L-1 TO EXISTING SANITARY PIPING.
- 221142 CORONER'S OFFICE ALTERNATE REFERENCED BY ENCLOSED ZONE. IF ALTERNATE IS NOT ACCEPTED, ALL ABOVE GRADE NEW DOMESTIC BRANCHES AND FIXTURES WILL NOT BE INSTALLED. PROVIDE PIPE TEES WITH SHUT-OFF VALVES AND CAPS FOR INSTALLATION IN FUTURE CONSTRUCTION. INSTALL BELOW GRADE DOMESTIC AND SANITARY WITH CAPS AT FLOOR.
- 221143 PUBLIC DEFENDER'S OFFICE ALTERNATE REFERENCED BY ENCLOSED ZONE. IF ALTERNATE IS NOT ACCEPTED, ALL ABOVE GRADE NEW DOMESTIC BRANCHES AND FIXTURES WILL NOT BE INSTALLED. PROVIDE PIPE TEES WITH SHUT-OFF VALVES AND CAPS FOR INSTALLATION IN FUTURE CONSTRUCTION. INSTALL BELOW GRADE DOMESTIC AND SANITARY WITH CAPS AT FLOOR. EXISTING SANITARY AND DOMESTIC PIPING SERVING EXISTING FIXTURES TO REMAIN FUNCTIONAL UNTIL FUTURE CONSTRUCTION.
- 221146 NEW WATER CLOSETS AND LAVATORIES TO BE CONNECTED TO EXISTING SANITARY PIPING.
- 221148 PROVIDE OPEN HUB CONNECTION FOR CONDENSATE LINE FROM DS-2. REFER TO M2.0 FOR PIPE ROUTING.
- 221151 CONNECT NEW SANITARY FLOOR DRAIN PIPING TO EXISTING SANITARY MAIN. CONTRACTOR TO COORDINATE LOCATION OF DRAIN WITH MECHANICAL EQUIPMENT IN SPACE.
- 221161 PROVIDE 1" CW(S) FOR REMOTE FLUSH VALVE. 1" LINE TO BE ROUTED FROM REMOTE FLUSH VALVE TO DT-1.
- 221306 CAP OFF SANITARY LINE TO WALL AND/OR FLOOR AND PATCH TO MATCH ADJACENT CONDITIONS. PIPING TO BE ABANDONED REFER TO SHEET PD1.0.
- 221307 CONNECT NEW SANITARY PIPE TO EXISTING SANITARY PIPE. CONTRACTOR TO VERIFY PIPE DEPTH OF EXISTING MAIN PRIOR TO INSTALLATION AND NOTIFY ENGINEER IF REQUIRED DROP NOT AVAILABLE.
- 221313 COORDINATE EXACT LOCATION OF FLUSHABLE DRAIN WITH OWNER PROVIDED AUTOPISTY TABLE.
- 221315 PROVIDE OPEN HUB CONNECTION WITH TRAP SEAL FOR ROUTING OF CONDENSATE PIPING FROM DUCTLESS SPLIT. REFER TO SHEET M2.0 FOR CONTINUATION.
- 221317 CAP ALL EXISTING SANITARY AND VENT LINES AT FLOOR.
- 221319 REGARDLESS OF ACCEPTANCE OF ALTERNATE. INSTALL BELOW GRADE SANITARY AND DOMESTIC PIPING. CAP AT FLOOR FOR USE IN FUTURE RENOVATION.
- 221407 INSTALL SUMP PUMP TO SERVE EXISTING BASIN AND CONNECT TO EXISTING STORM WATER FORCE MAIN.
- 221409 INSTALL SUMP PUMP IN EXISTING BASIN AND CONNECT TO EXISTING SANITARY MAIN TO SEWAGE MAIN.
- 221410 INSTALL ELEVATOR SUMP PUMP IN EXISTING BASIN. CONNECT TO EXISTING SANITARY PIPING.

--- ALTERNATE BOUNDARY AS NOTED/LABELED

NOTE:
ELEMENTS ON THIS DRAWING ARE IDENTIFIED BY VARIOUS COLORS; IF THIS NOTE IS NOT RED, THIS DRAWING IS NOT IN COLOR AND NEEDS TO BE REPRESENTED IN COLOR.

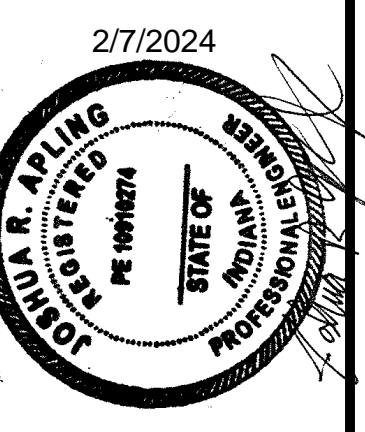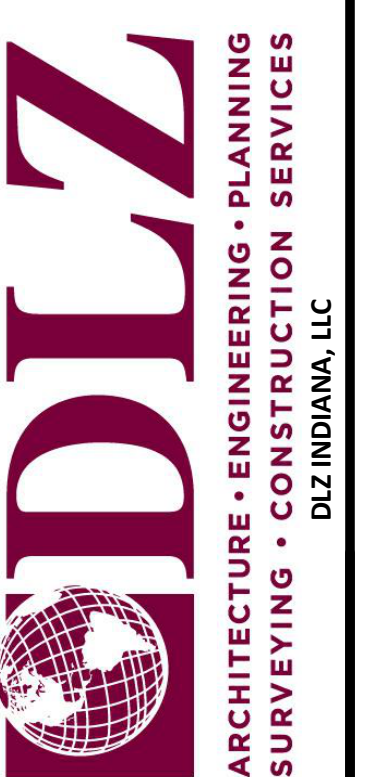

DATE	REVISION	NO.	NO.
2/7/24	2 - ADDENDUM 4	2	2

HANCOCK COUNTY BOARD OF COMMISSIONERS
OFFICE RENOVATIONS
 123 E. MAIN STREET
 UNDERFLOOR PLUMBING PLAN LOWER LEVEL


PROJECT NUMBER: 2103-1063-90

DRAWN: CRWK
 DESIGNED: CRWK
 APPROVED: JRA
 DATE: DECEMBER 21, 2023

DRAWING NUMBER: **P1.1**
 PLUMBING

1 UNDERFLOOR PLUMBING INSTALLATION PLAN
 SCALE: 1/8" = 1'-0"
 NORTH

C:\Rev\Backups\2023\163-1063-90_Hancock_Co_Jail_Mech_stairs_dwg.rvt
 2/9/2024 4:15:14 PM

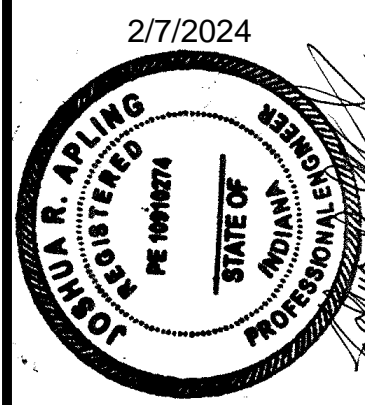


- GENERAL NOTES**
- REFER TO SHEETS G1.1 AND P0.1 FOR ADDITIONAL GENERAL NOTES AND INFORMATION.
 - WHERE PIPE SIZE MAY NOT BE INDICATED SERVING A FIXTURE, PROVIDE SIZES AS INDICATED IN THE PLUMBING FIXTURE SCHEDULE.
 - INSTALL ALL EQUIPMENT, FIXTURES, AND ASSOCIATED ACCESSORIES PER MANUFACTURER RECOMMENDATIONS.
 - COORDINATE WITH ALL OTHER DISCIPLINES BEFORE INSTALLING ANY PIPING DEVICES.
 - INVERT ELEVATIONS ARE BASED ON 100.00' FINISHED FIRST FLOOR ELEVATION TO BOTTOM OF PIPE. SITE / CIVIL PLANS ESTABLISH FINISHED FLOOR ELEVATION.
 - PROVIDE GAS PRESSURE REGULATORS AS NEEDED FOR EQUIPMENT.
 - EXACT LOCATION OF PLUMBING FIXTURES SHALL BE COORDINATED WITH THE ARCHITECTURAL PLANS TO MEET A.D.A. REQUIREMENTS.

- PLUMBING KEYNOTES**
- 221105 HWR SELF-ACTUATING THERMOSTATIC BALANCING VALVE SIMILAR TO CIRCUIT SOLVER OR EQUAL. PROVIDE TWO (2) SHUT-OFF VALVES WITH CHECK AND BALANCE VALVE BETWEEN.
 - 221107 PIPING UP THROUGH FLOOR ABOVE
 - 221110 CONNECT EXISTING 1" DCW PIPING SERVING DETOX TOILET FLUSHVALVE TO NEW DOMESTIC MAIN.
 - 221111 CONNECT EXISTING ROUTING OF DOMESTIC PIPING SERVING FIRST FLOOR CELLS TO NEW DOMESTIC MAINS.
 - 221113 IF CORONERS OFFICE ALTERNATE BID IS NOT ACCEPTED, DOMESTIC WATER PIPING AND FIXTURES IN AUTOPIST 011 AND TOILET/SHOWER 015 IS NOT TO BE INSTALLED. PROVIDE PIPE WITH SHUT-OFF VALVE AND CAPS FOR FUTURE RENOVATION.
 - 221115 INSTALL NEW FLUSH VALVE ON TO EXISTING PIPING SERVING FLUSHABLE DETOX TOILET ABOVE.
 - 221117 CONNECT EXISTING DOMESTIC LINES SERVING JANITORS MOP SINK TO NEW DOMESTIC MAINS.
 - 221118 CONNECT EXISTING DOMESTIC HOT WATER RETURN TO NEW HOT WATER RETURN MAIN.
 - 221119 EXISTING DOMESTIC AND SANITARY LINE SERVING CELLS ABOVE.
 - 221120 EXISTING DOMESTIC LINE SERVING CELLS ABOVE.
 - 221122 EXISTING DOMESTIC AND SANITARY LINES SERVING MOP SINK AND EWC ABOVE.
 - 221123 EXISTING DOMESTIC AND SANITARY LINES SERVING EWC ABOVE.
 - 221126 DOMESTIC PIPING SERVING TOILET 120 ABOVE. PROVIDE SHUT-OFF VALVE, CHECK VALVE, AND SHUT-OFF VALVE IN THE DIRECTION OF WATER FLOW. BALANCE TO FLOW INDICATED.
 - 221127 INSTALL 3/4" DCW PIPE TO SERVE EXISTING HOSE BIBB.
 - 221128 INSTALL 3/4" DCW PIPE TO SERVE EXISTING WALL HYDRANT.
 - 221147 ROUTE NEW DCW PIPING TO EXISTING EXTERIOR HOSE BIBB.
 - 221142 CORONERS OFFICE ALTERNATE REFERENCED BY ENCLOSED ZONE. IF ALTERNATE IS NOT ACCEPTED, ALL ABOVE GRADE NEW DOMESTIC BRANCHES AND FIXTURES WILL NOT BE INSTALLED. PROVIDE PIPE TEES WITH SHUT-OFF VALVES AND CAPS FOR INSTALLATION IN FUTURE CONSTRUCTION. INSTALL BELOW GRADE DOMESTIC AND SANITARY WITH GAPS AT FLOOR.
 - 221143 PUBLIC DEFENDER'S OFFICE ALTERNATE REFERENCED BY ENCLOSED ZONE. IF ALTERNATE IS NOT ACCEPTED, ALL ABOVE GRADE NEW DOMESTIC BRANCHES AND FIXTURES WILL NOT BE INSTALLED. PROVIDE PIPE TEES WITH SHUT-OFF VALVES AND CAPS FOR INSTALLATION IN FUTURE CONSTRUCTION. INSTALL BELOW GRADE DOMESTIC AND SANITARY WITH GAPS AT FLOOR. EXISTING SANITARY AND DOMESTIC PIPING SERVING EXISTING FIXTURES TO REMAIN FUNCTIONAL UNTIL FUTURE CONSTRUCTION.
 - 221147 CONNECT EXISTING 3" STORM PIPING TO NEW 6" STORM MAIN.
 - 221161 PROVIDE 1" CW(S) FOR REMOTE FLUSH VALVE. 1" LINE TO BE ROUTED FROM REMOTE FLUSH VALVE TO DT-1.
 - 221162 CONNECT NEW 3" GAS PIPING TO EXISTING GAS METER. PROVIDE PRESSURE REGULATING VALVE TO 14" W.C.
 - 221163 DOMESTIC AND VENT PIPING SERVING AUTOPIST SINK.
 - 221304 SEAL PIPE AT WALL.
 - 221307 CONNECT NEW SANITARY PIPE TO EXISTING SANITARY PIPE. CONTRACTOR TO VERIFY PIPE DEPTH OF EXISTING MAIN PRIOR TO INSTALLATION AND NOTIFY ENGINEER IF REQUIRED DROP NOT AVAILABLE.
 - 221310 CONNECT NEW VENT PIPING TO EXISTING VENT PIPING.
 - 221315 PROVIDE OPEN HUB CONNECTION WITH TRAP SEAL FOR ROUTING OF CONDENSATE PIPING FROM DUCTLESS SPLIT. REFER TO SHEET M2.0 FOR CONTINUATION.
 - 221320 EXISTING SANITARY PIPING SERVING RESTROOM ABOVE.
 - 221406 CONNECT EXISTING STORM PIPING TO NEW STORM PIPING.
 - 221411 COORDINATE ROUTING OF STORM RISE WITH HVAC DUCTWORK IN CHASE. CONNECT STORM PIPING TO NEW STORM MAIN.

--- ALTERNATE BOUNDARY AS NOTED/LABELLED

NOTE:
 ELEMENTS ON THIS DRAWING ARE IDENTIFIED BY VARIOUS COLORS; IF THIS NOTE IS NOT RED, THIS DRAWING IS NOT IN COLOR AND NEEDS TO BE REPRINTED IN COLOR.

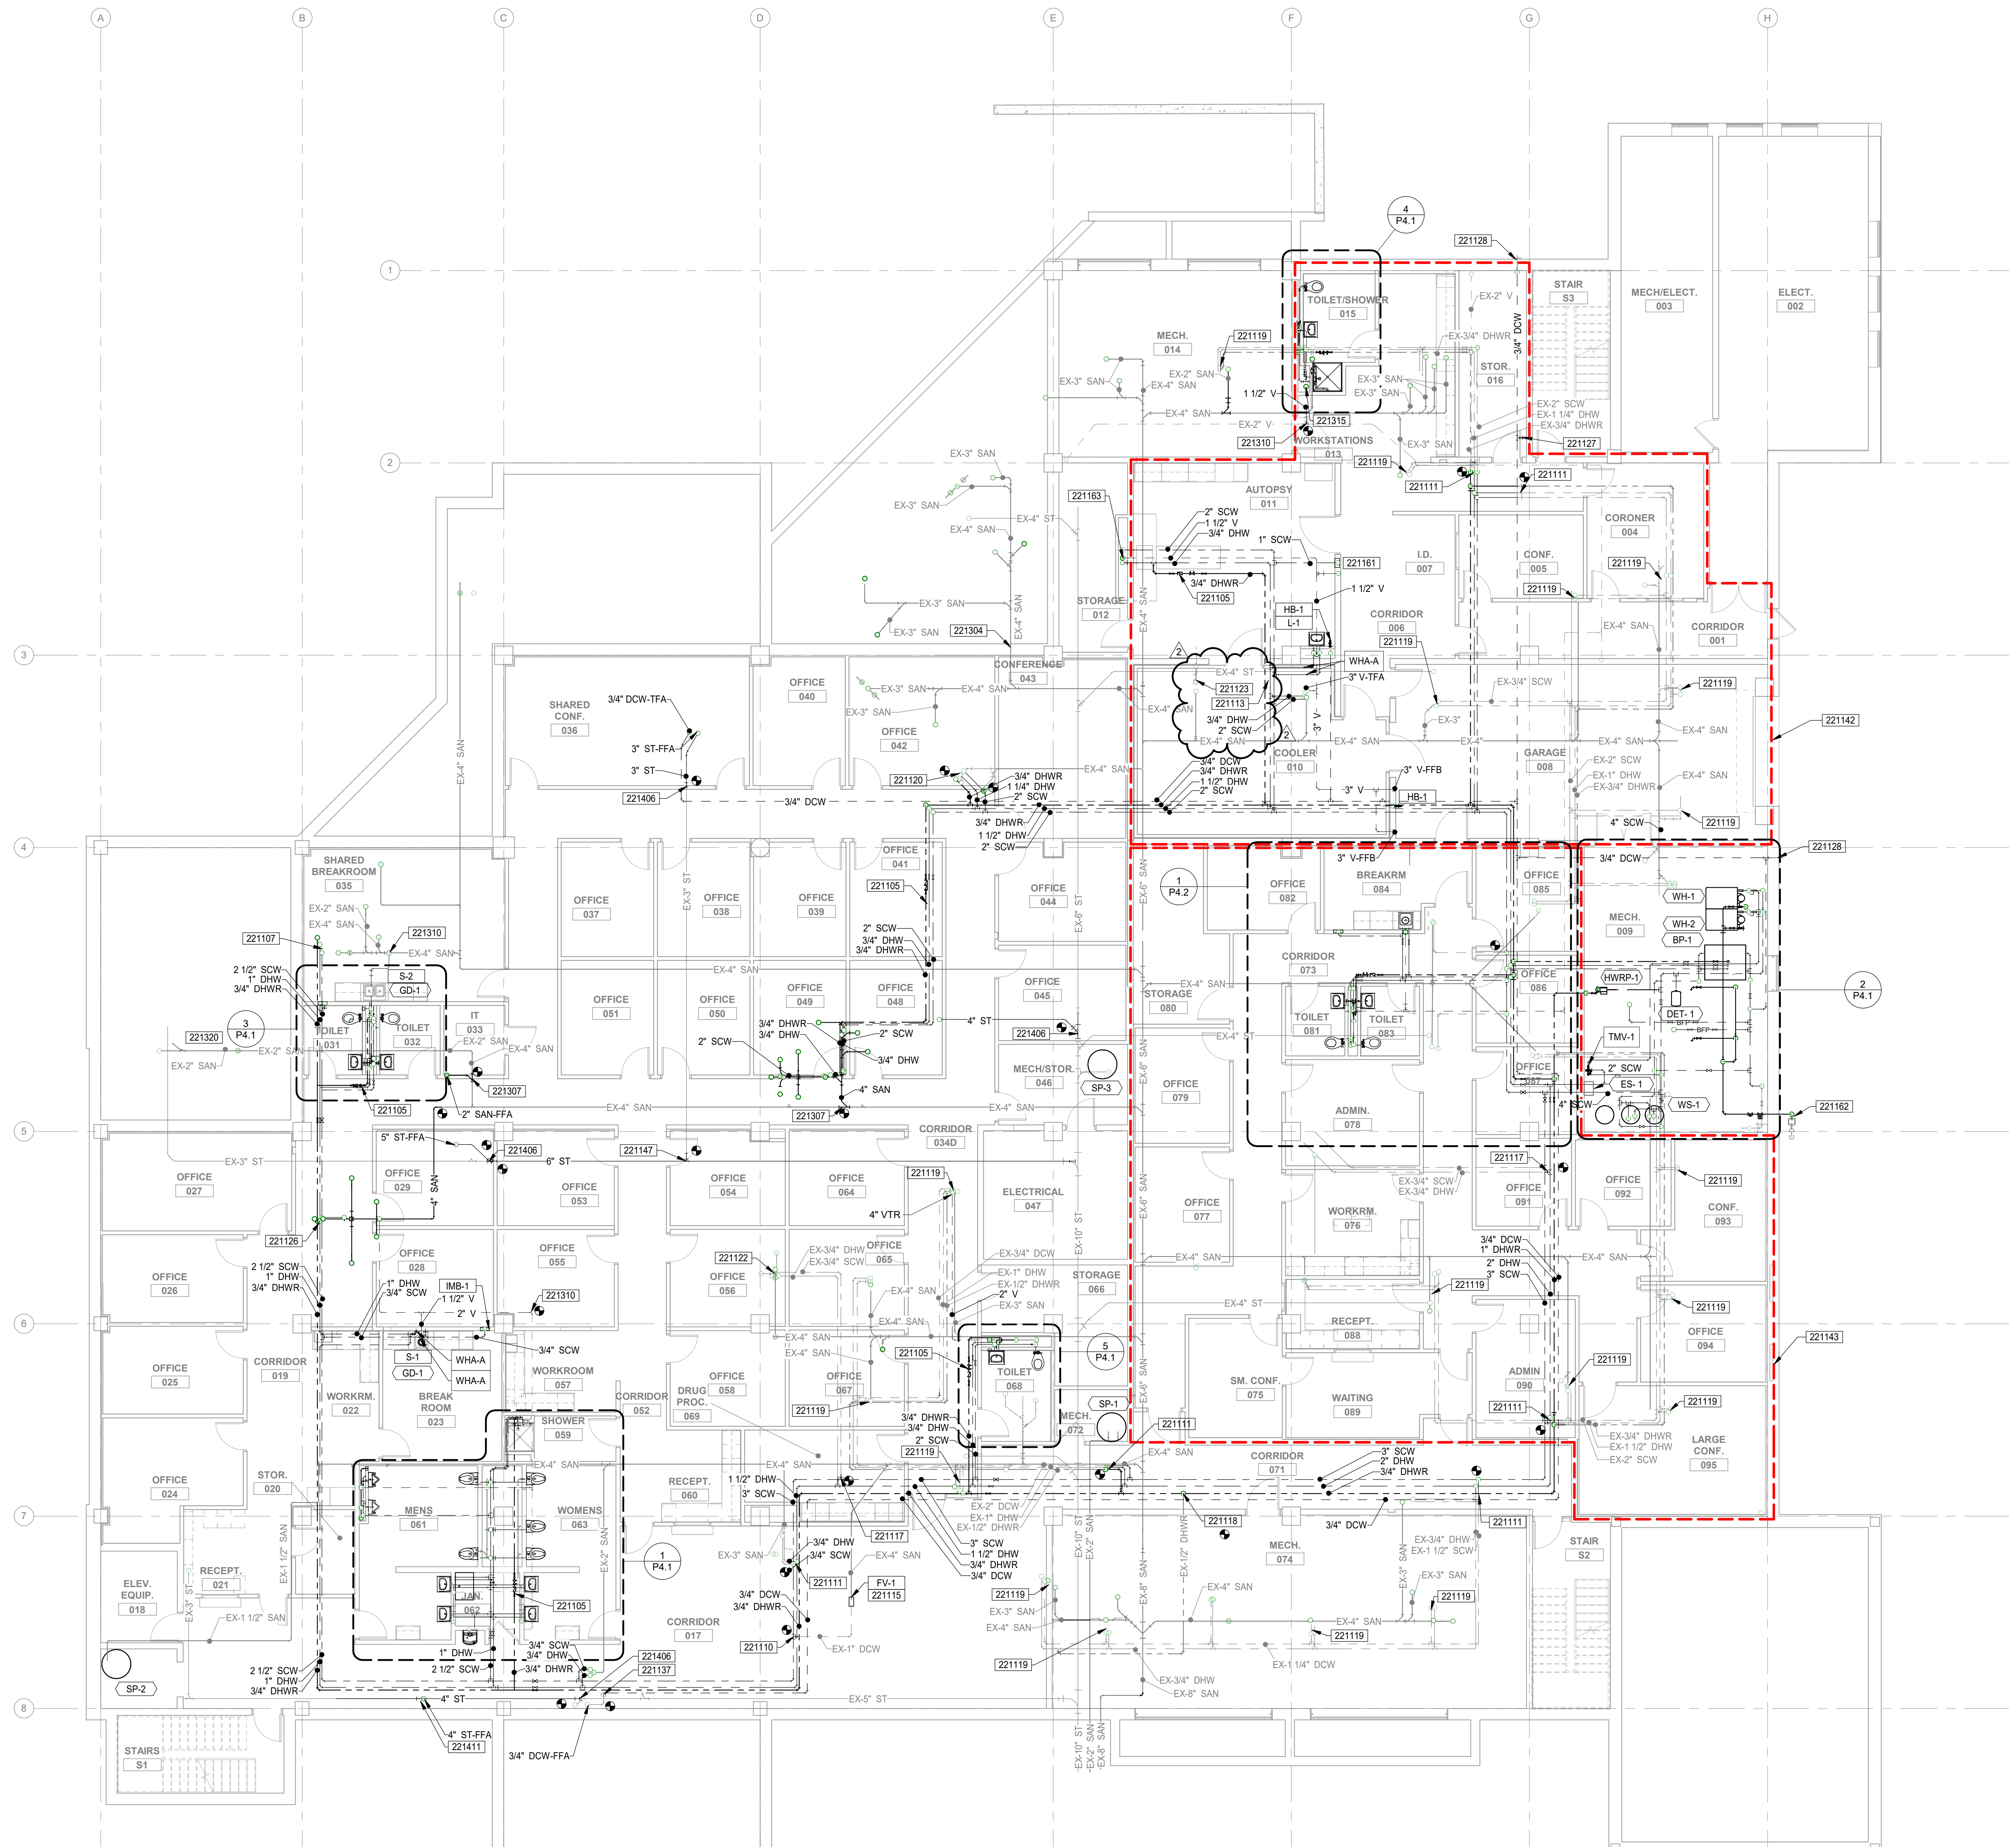

LOWER LEVEL PLUMBING INSTALLATION PLAN
 SCALE: 1/8" = 1'-0"
 NORTH

DATE	REVISION	NO.	DESCRIPTION
2/7/24	2	ADDENDUM 4	

DRAWN: JRA	CHKD: JRA
DESIGNED: CRWK	APPRVD: JRA
DATE: DECEMBER 21, 2023	

PROJECT NUMBER
2163-1063-90


HANCOCK COUNTY BOARD OF COMMISSIONERS
OFFICE RENOVATIONS
 123 E. MAIN STREET
 LOWER LEVEL OVERALL PLUMBING PLAN

DRAWING NUMBER


P2.1

PLUMBING


C:\Revs\Backups\2022\2163-1063-90_Hancock_Co_Jail_Mech_Stacks.dwg,nt
2/8/2024 4:19:36 PM

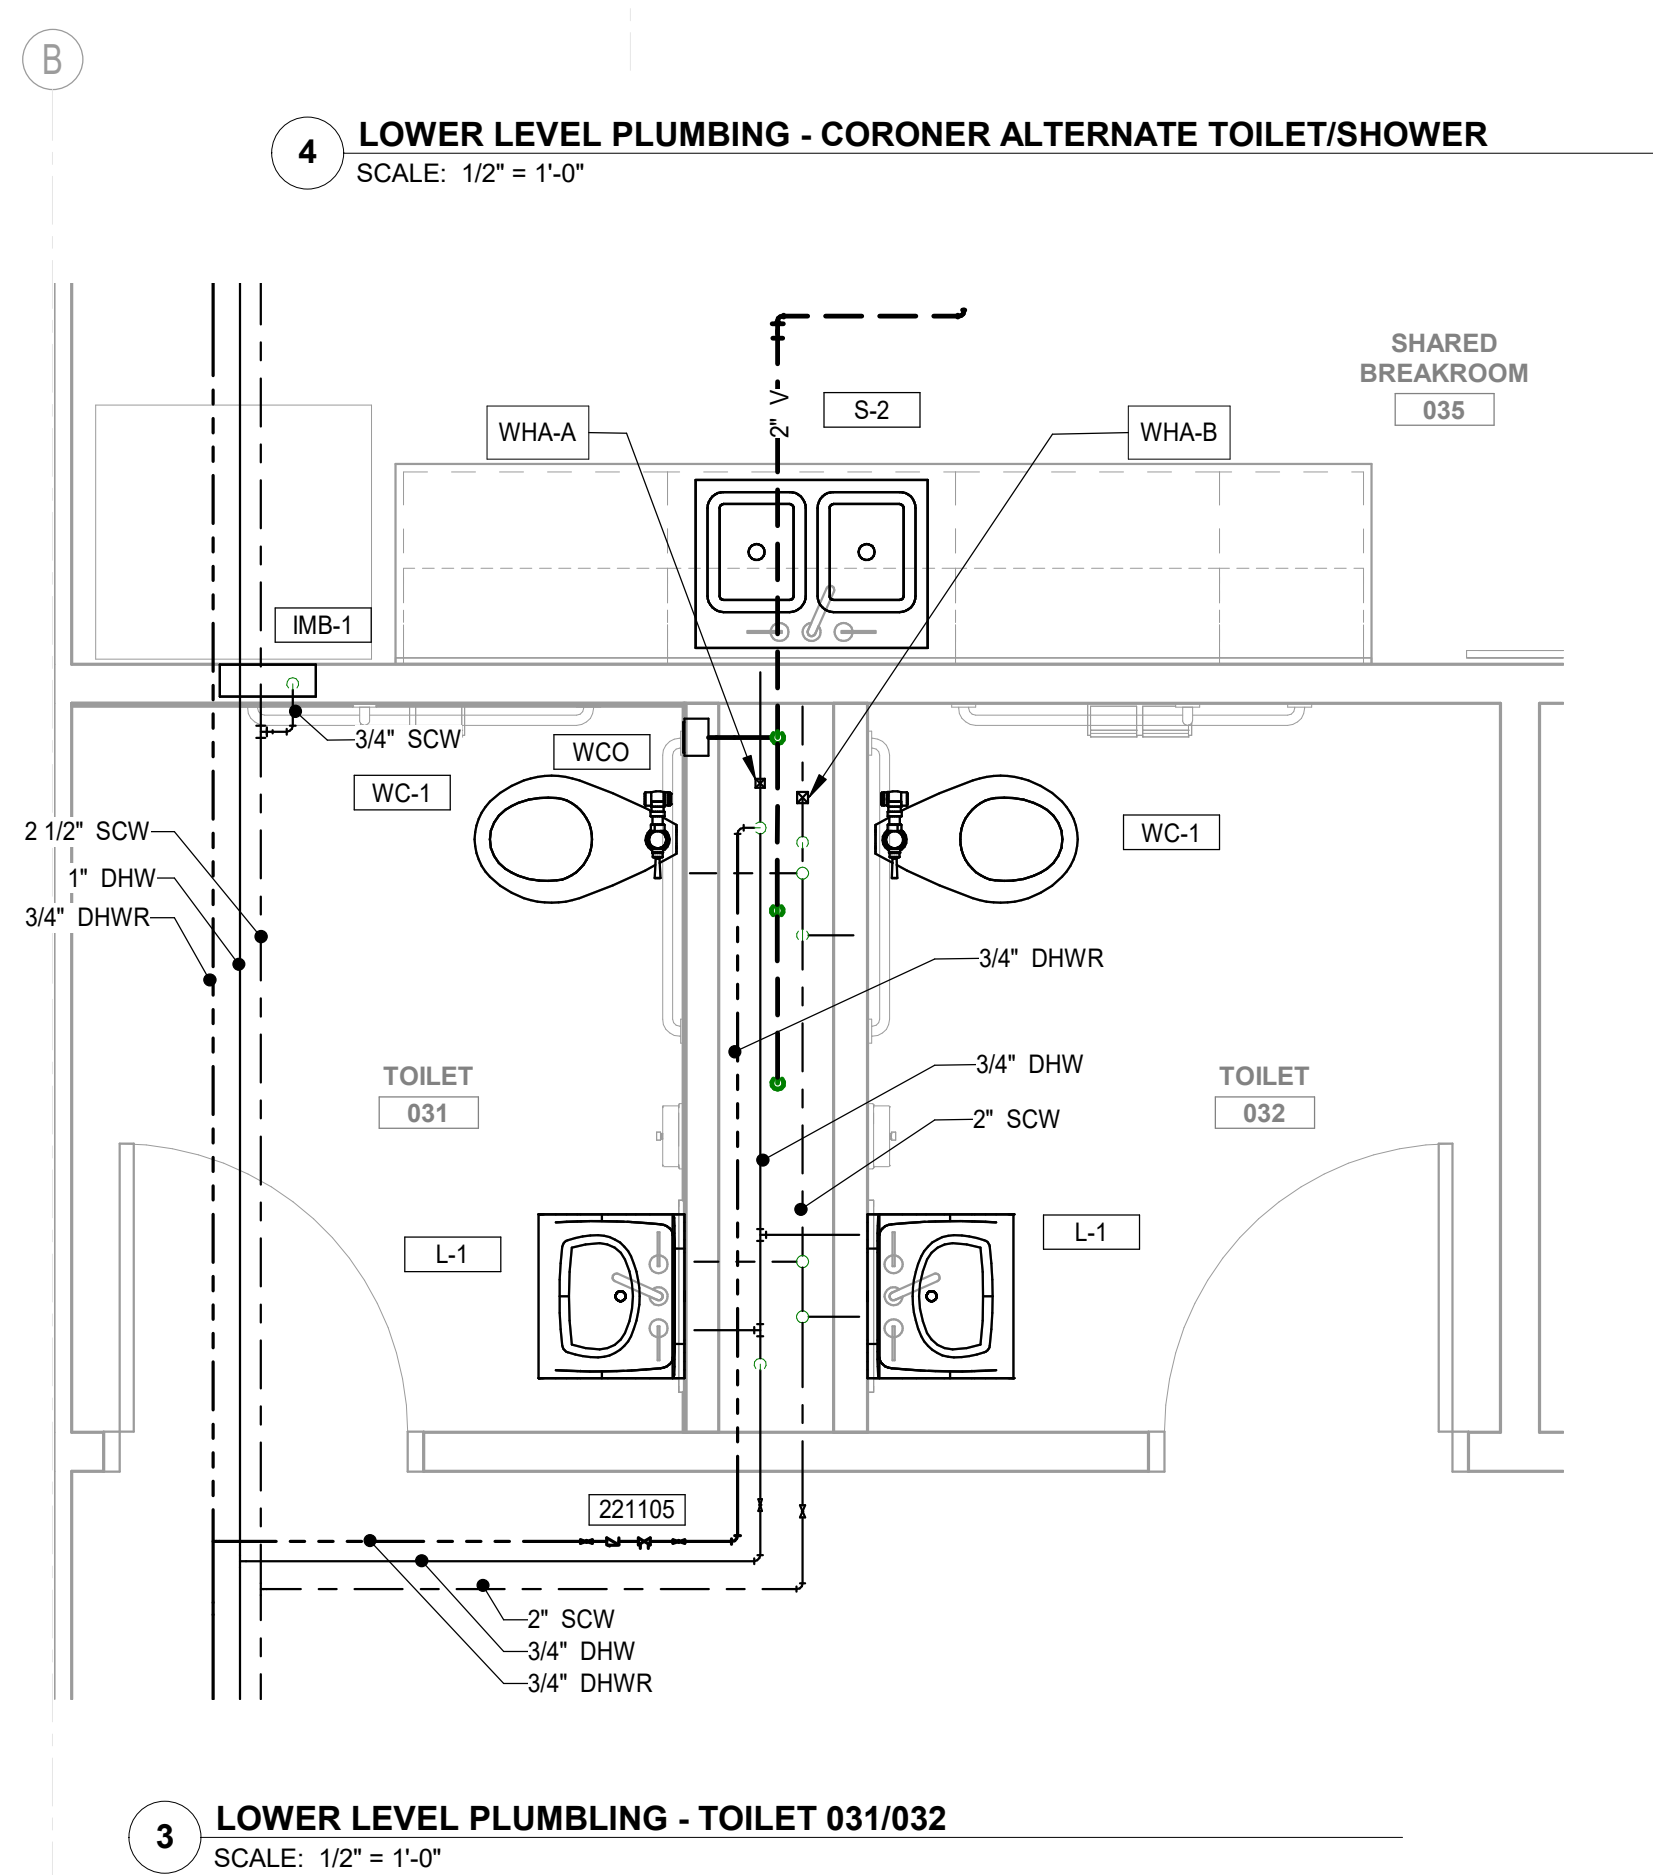


3 LOWER LEVEL PLUMBING - TOILET 031/032
SCALE: 1/2" = 1'-0"

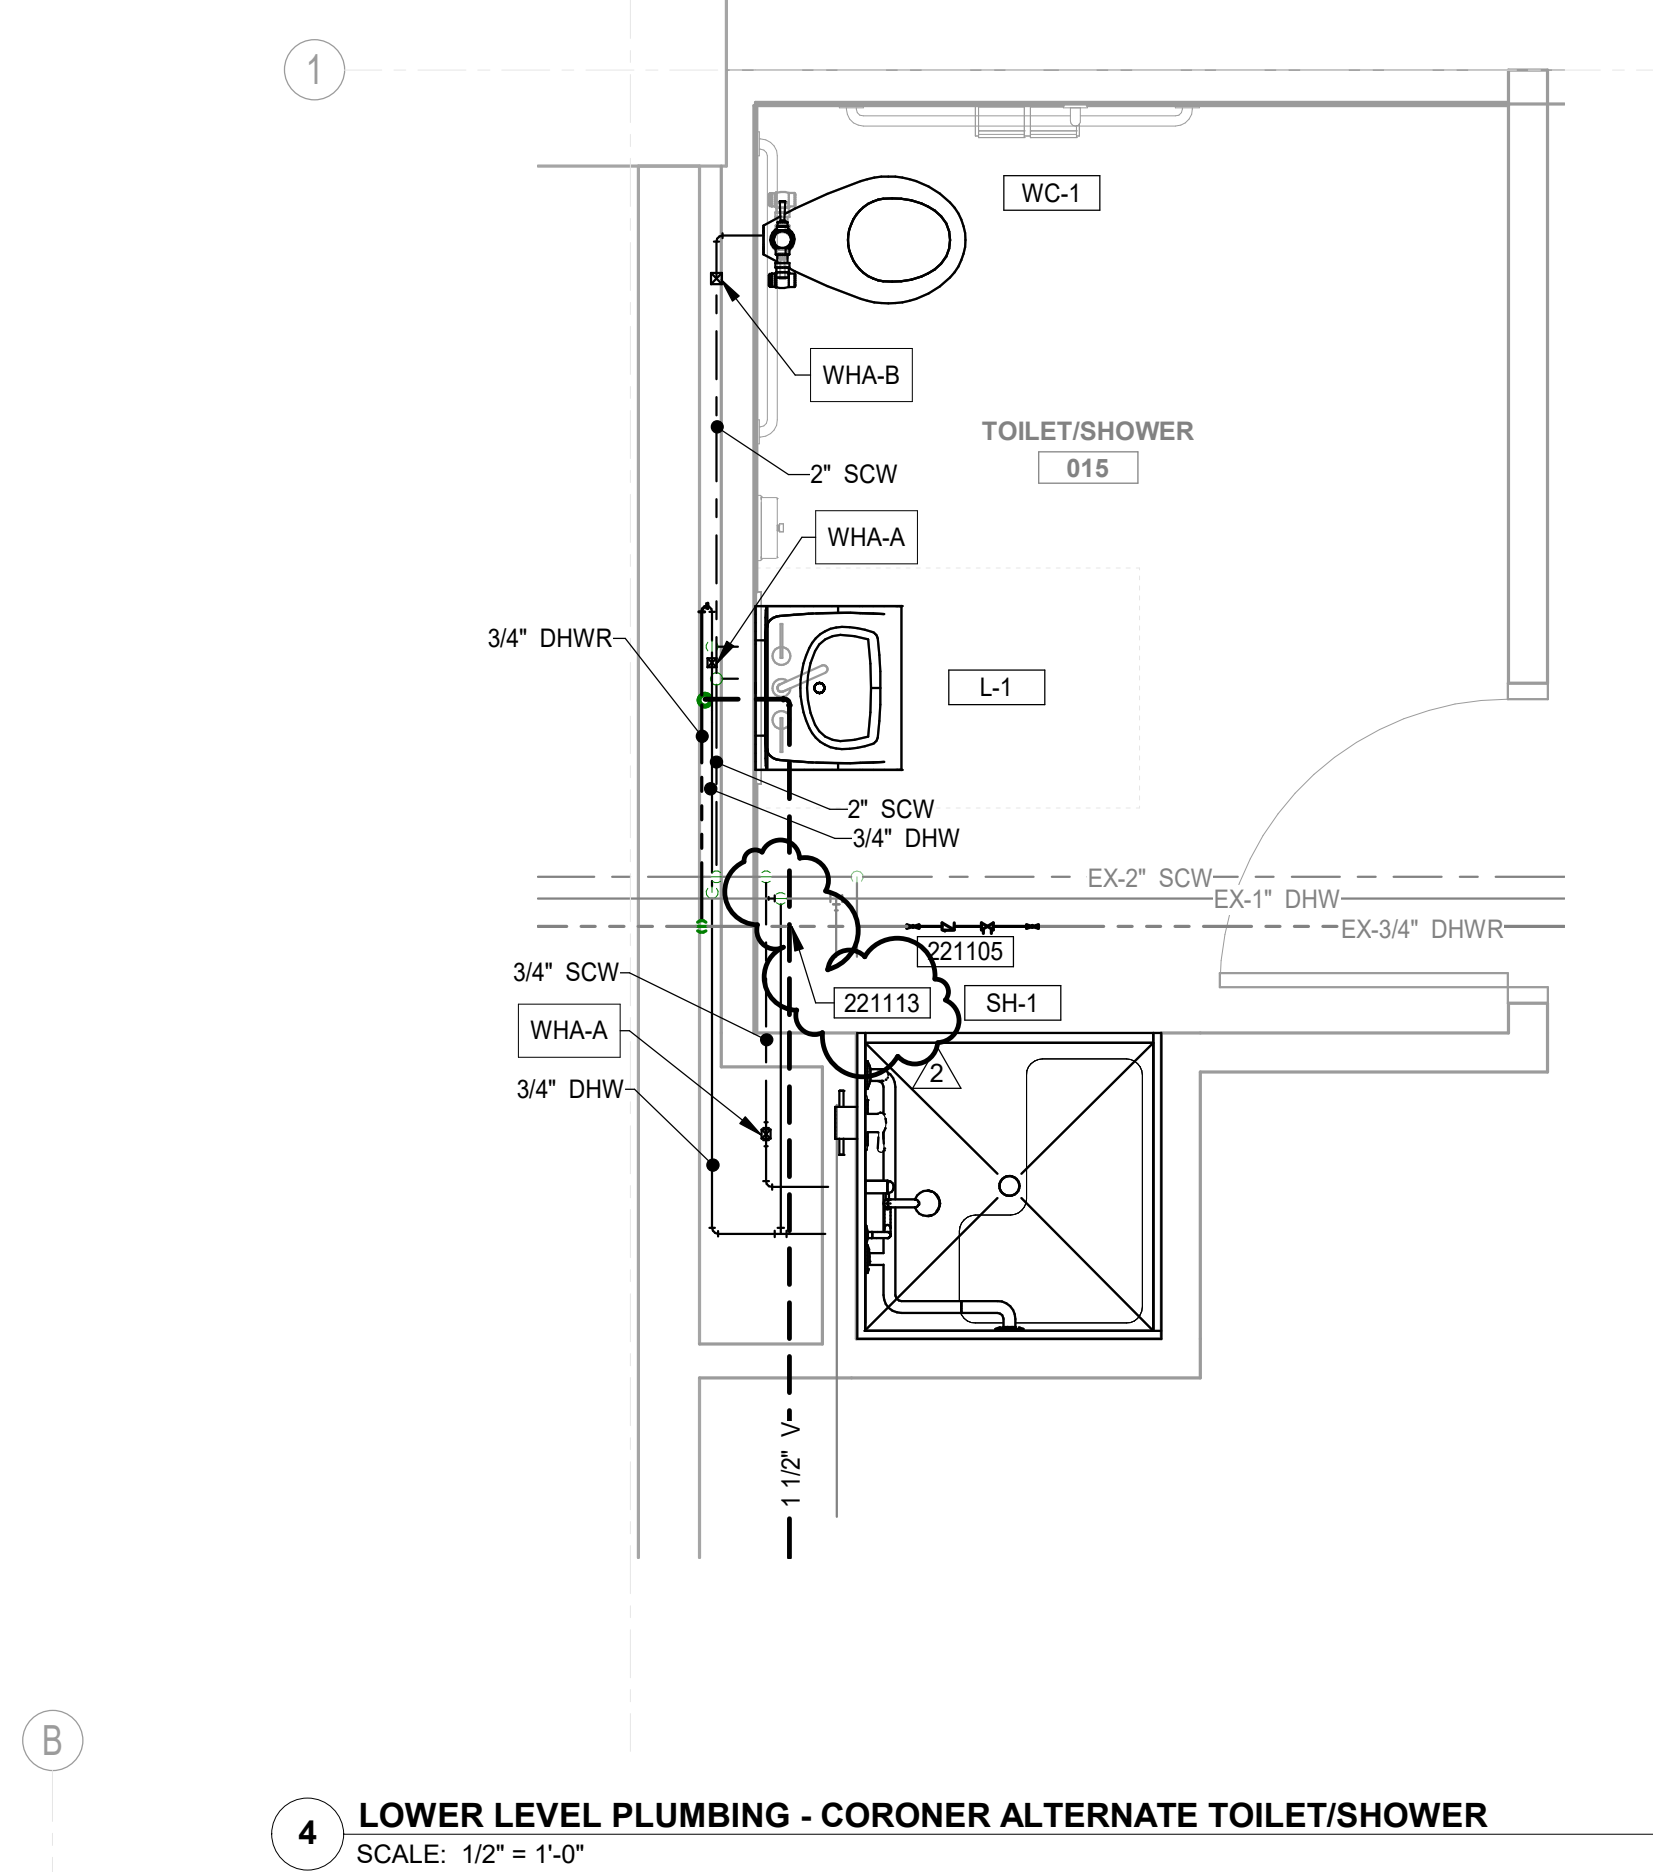


4 LOWER LEVEL PLUMBING - CORONER ALTERNATE TOILET/SHOWER
SCALE: 1/2" = 1'-0"

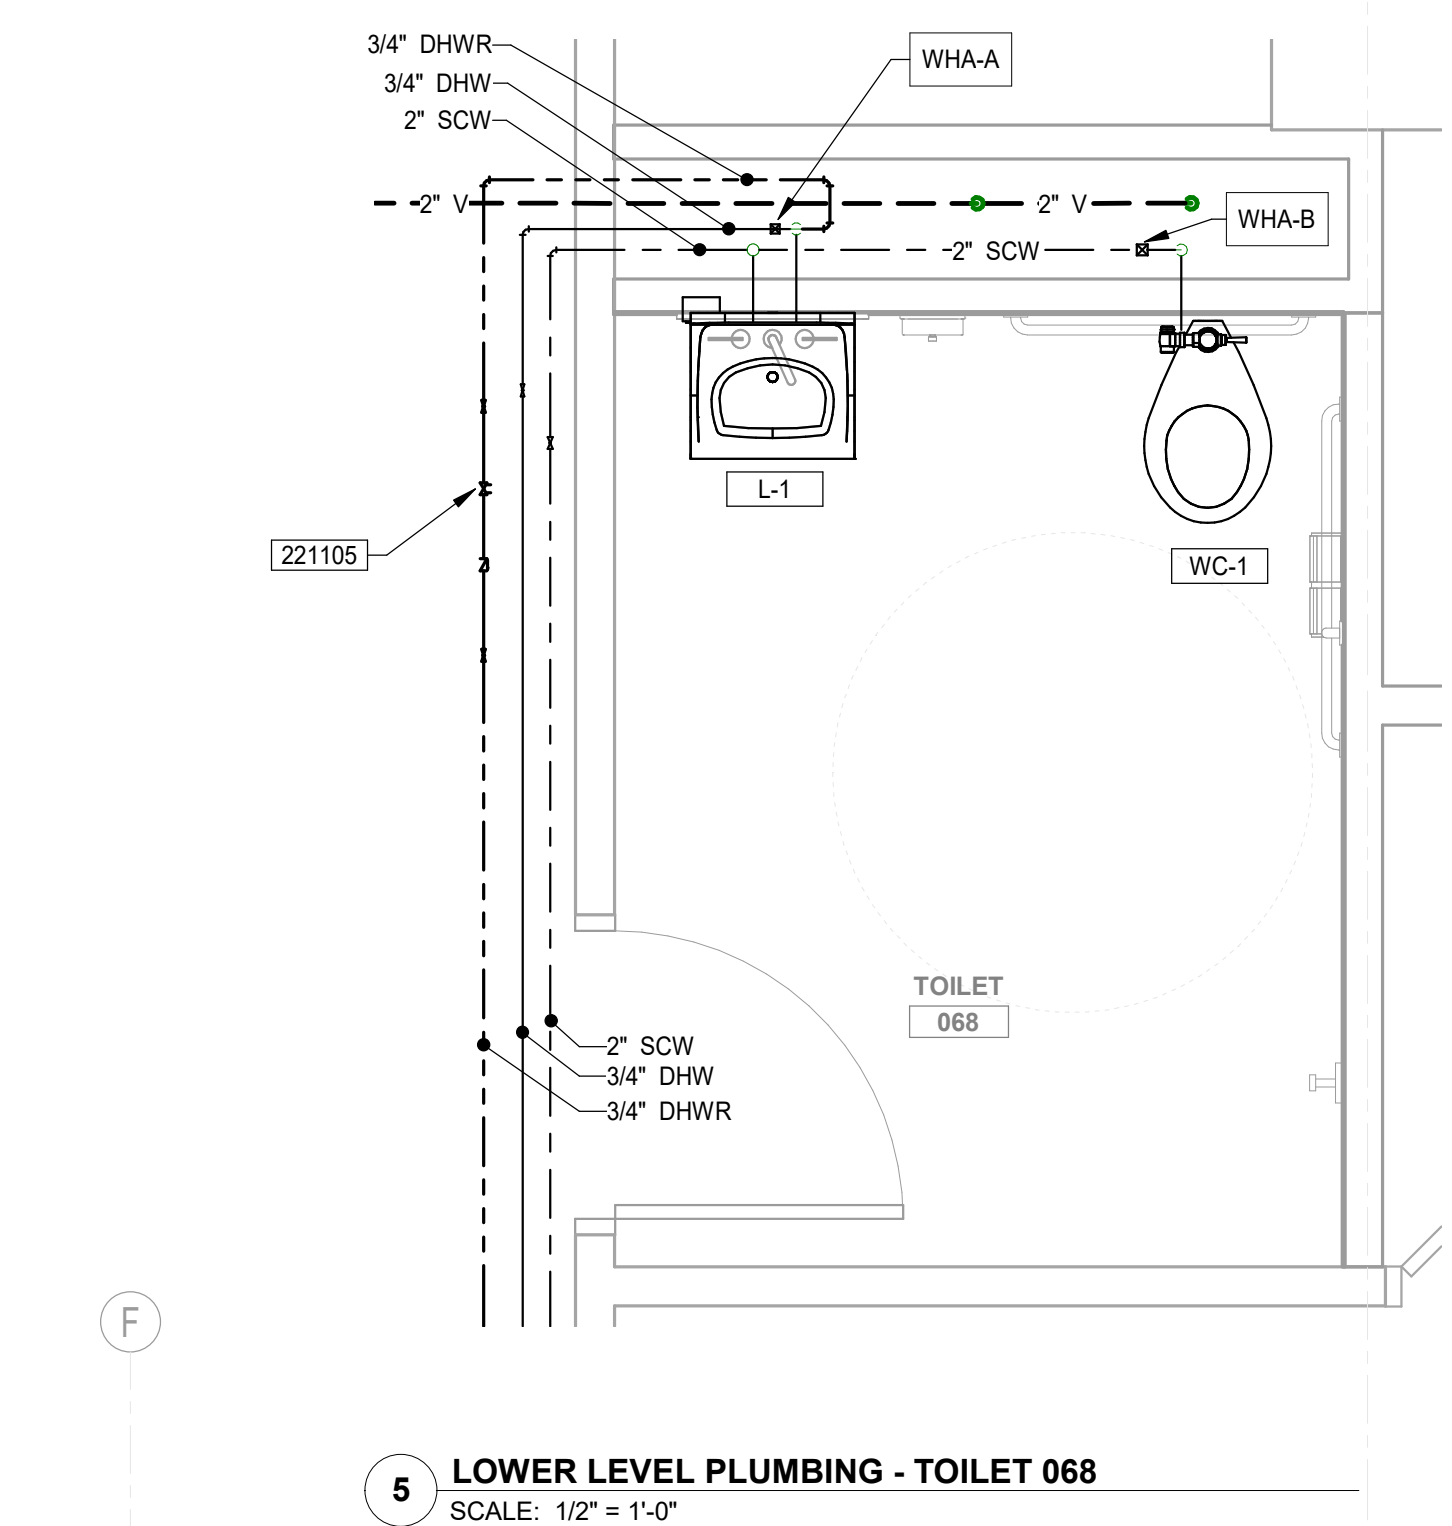

5 LOWER LEVEL PLUMBING - TOILET 068
SCALE: 1/2" = 1'-0"

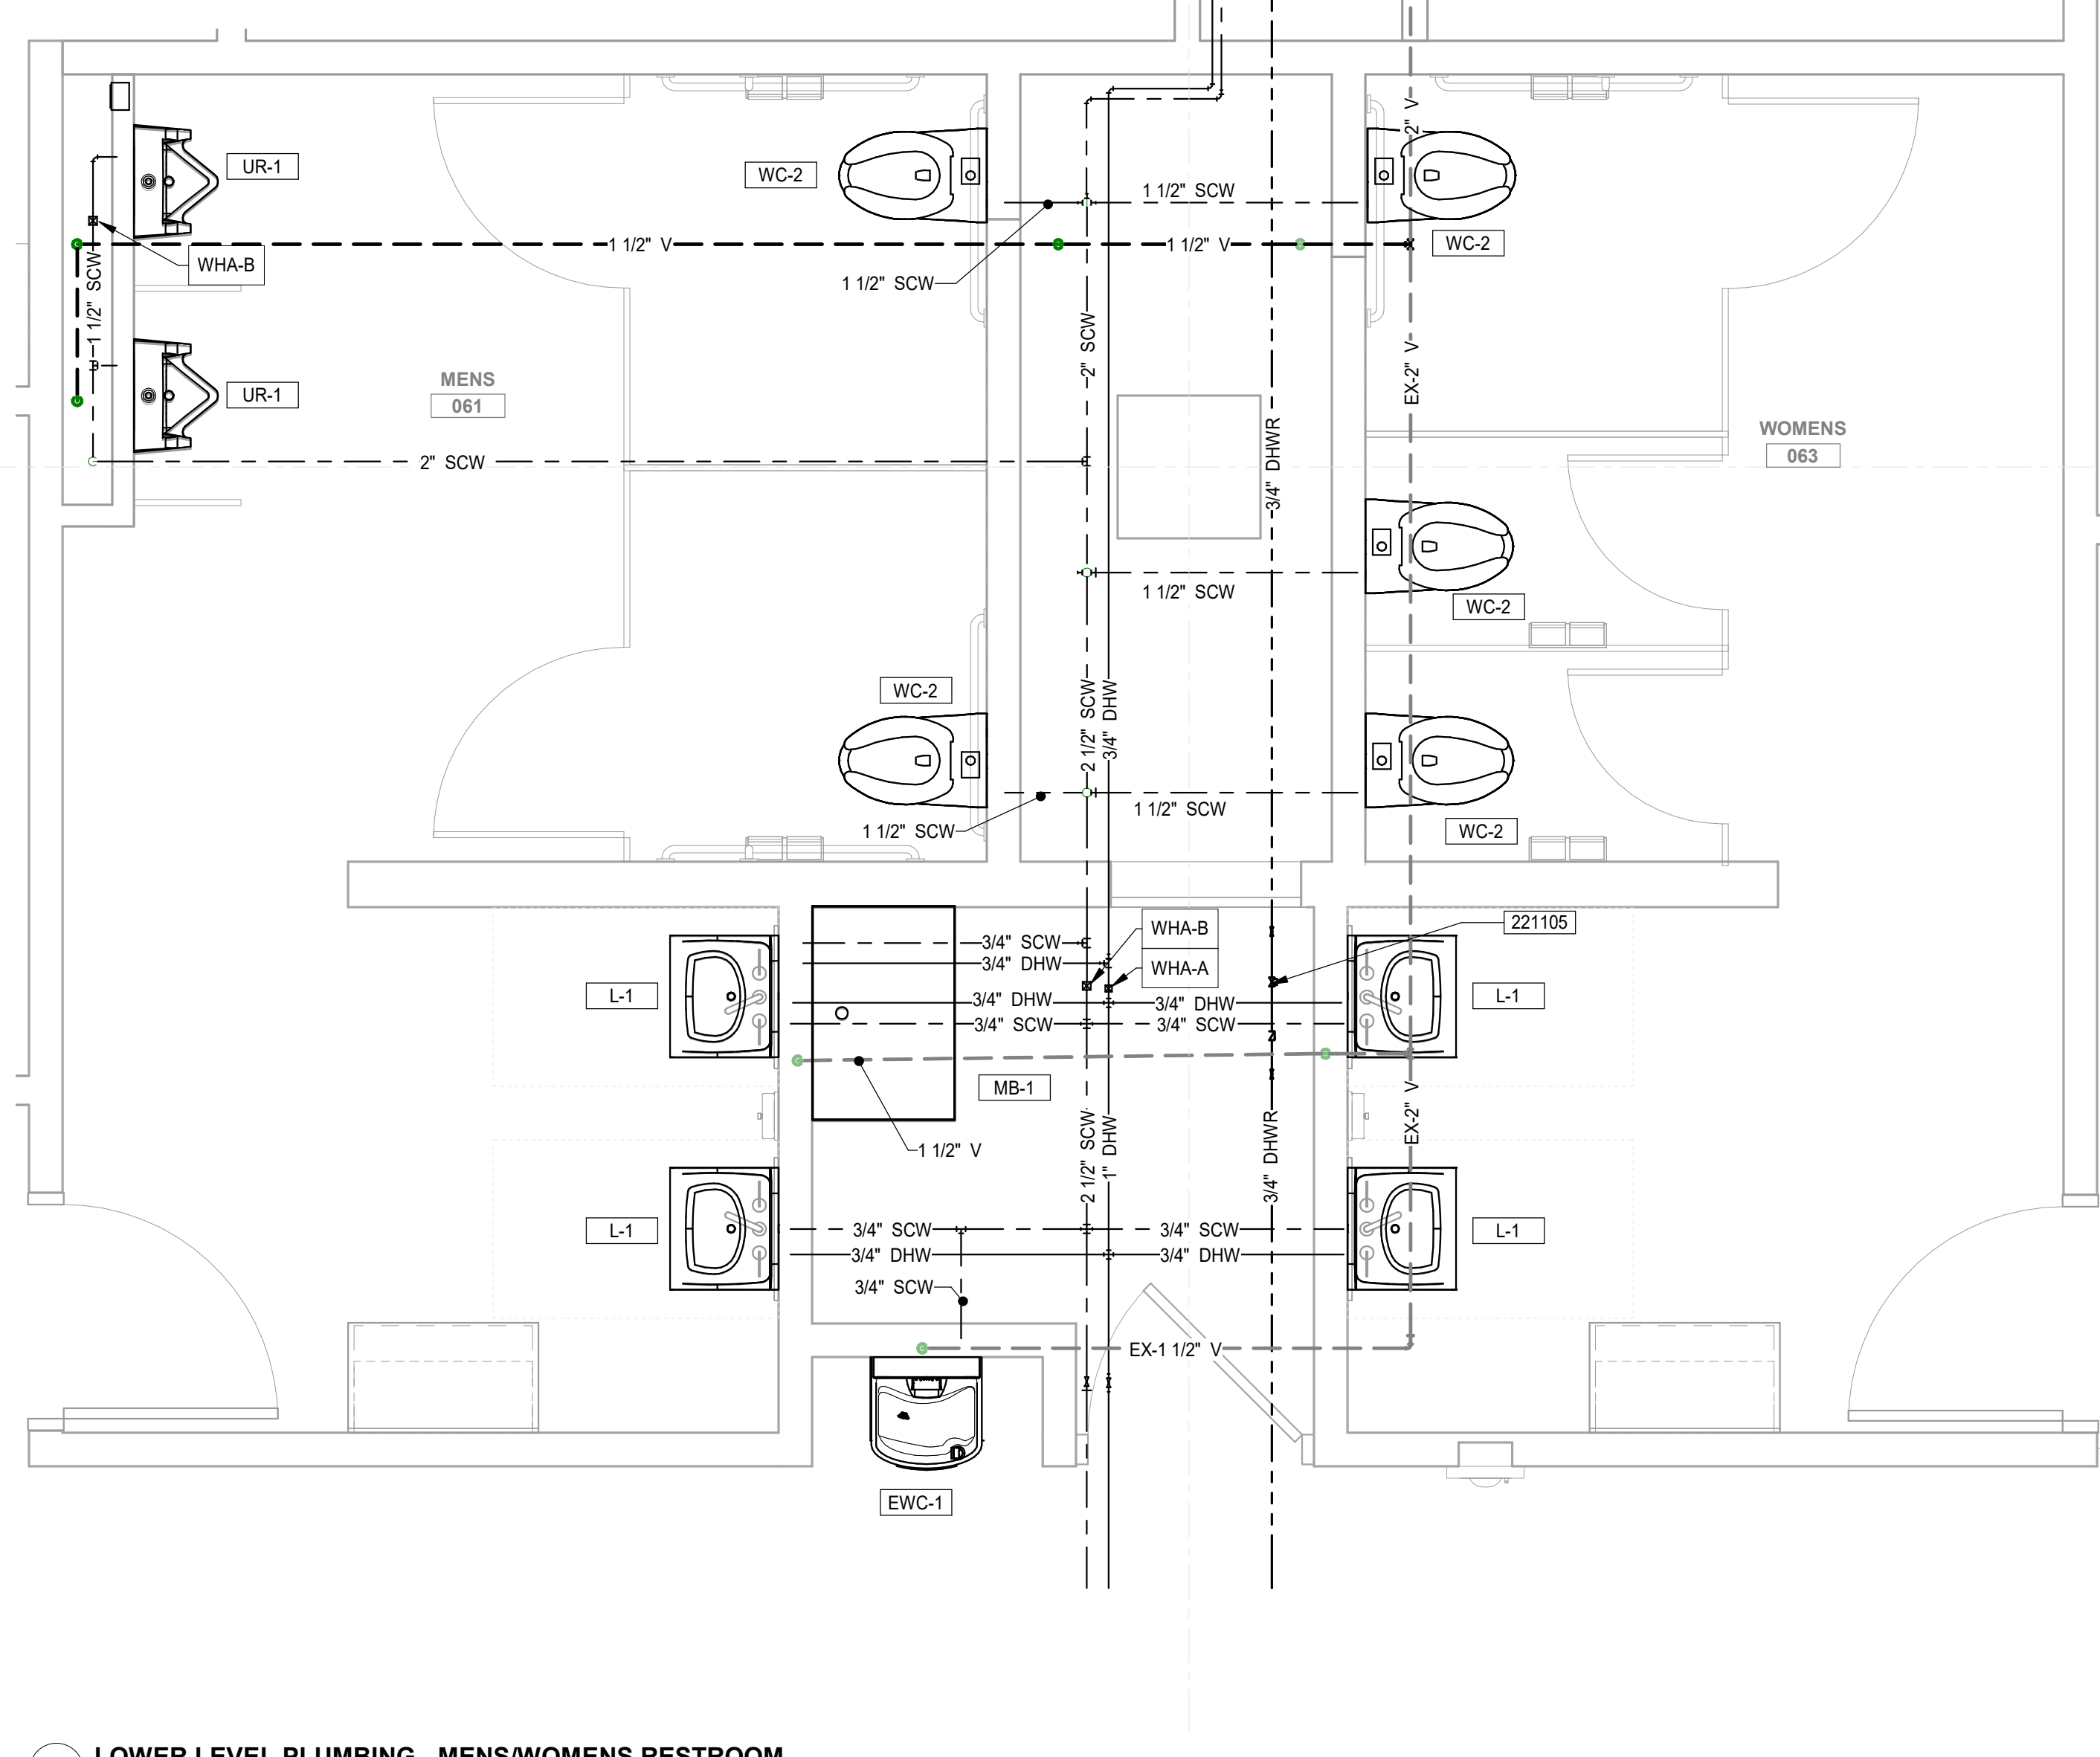

1 LOWER LEVEL PLUMBING - MENS/WOMENS RESTROOM
SCALE: 1/2" = 1'-0"

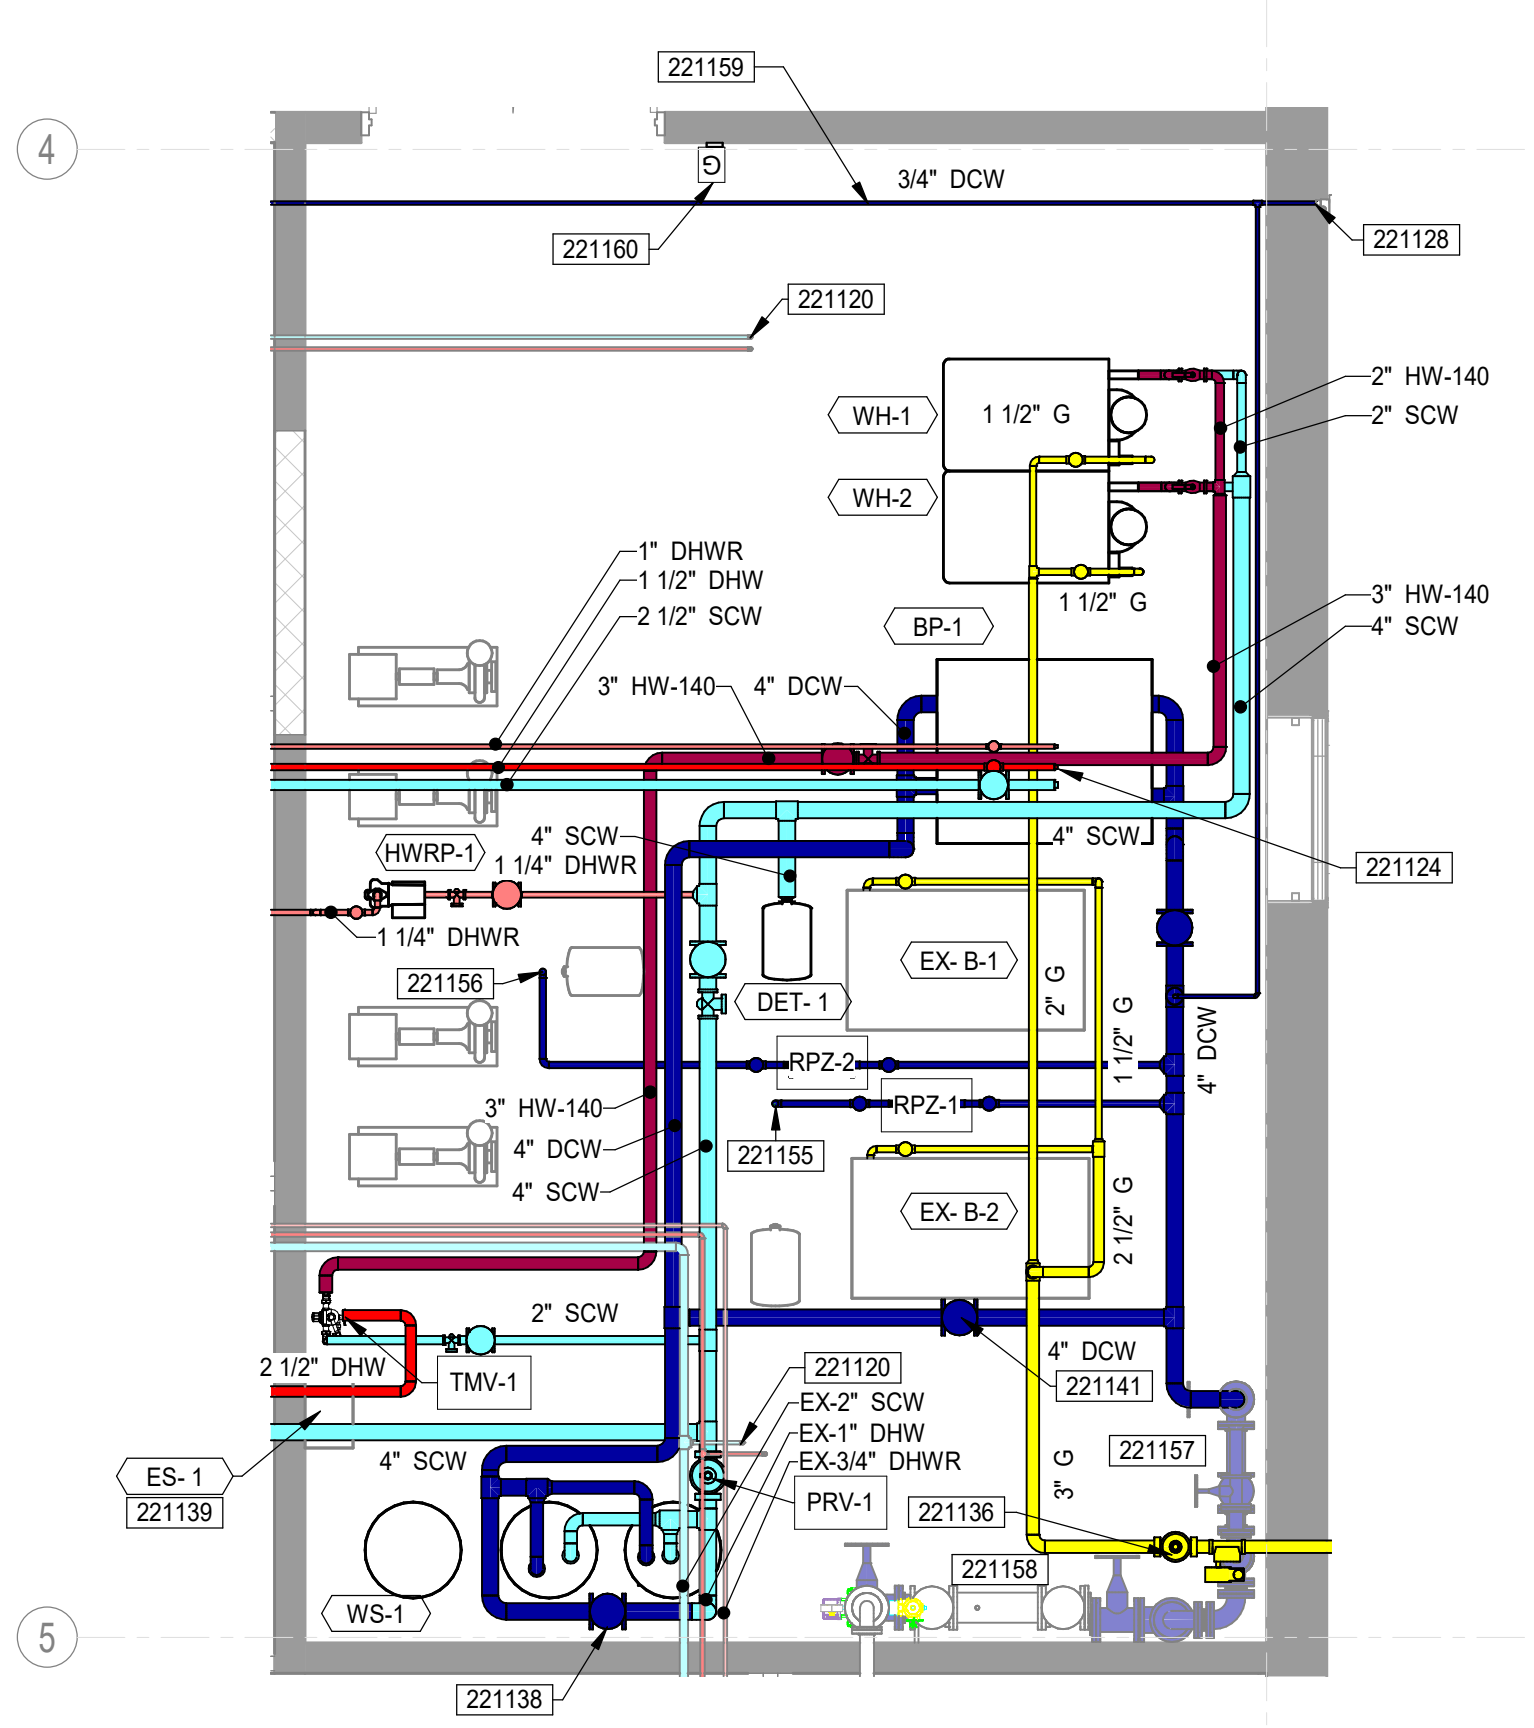

2 LOWER LEVEL PLUMBING - MECHANICAL ROOM 009
SCALE: 1/4" = 1'-0"


GENERAL NOTES

- A. REFER TO SHEETS G1.1 AND P0.1 FOR ADDITIONAL GENERAL NOTES AND INFORMATION.
- B. WHERE PIPE SIZE MAY NOT BE INDICATED SERVING A FIXTURE, PROVIDE SIZES AS INDICATED IN THE PLUMBING FIXTURE SCHEDULE.
- C. INSTALL ALL EQUIPMENT, FIXTURES, AND ASSOCIATED ACCESSORIES PER MANUFACTURER RECOMMENDATIONS.
- D. COORDINATE WITH ALL OTHER DISCIPLINES BEFORE INSTALLING ANY PIPING DEVICES.
- E. INVERT ELEVATIONS ARE BASED ON 100.00' FINISHED FIRST FLOOR ELEVATION TO BOTTOM OF PIPE. SITE / CIVIL PLANS ESTABLISH FINISHED FLOOR ELEVATION.
- F. PROVIDE GAS PRESSURE REGULATORS AS NEEDED FOR EQUIPMENT.
- G. EXACT LOCATION OF PLUMBING FIXTURES SHALL BE COORDINATED WITH THE ARCHITECTURAL PLANS TO MEET A.D.A. REQUIREMENTS.

PLUMBING KEYNOTES

- 221105 HWR SELF-ACTUATING THERMOSTATIC BALANCING VALVE SIMILAR TO CIRCUIT SOLVER OR EQUAL. PROVIDE TWO (2) SHUT-OFF VALVES WITH CHECK AND BALANCE VALVE BETWEEN.
- 221113 IF CORONERS OFFICE ALTERNATE BID IS NOT ACCEPTED, DOMESTIC WATER PIPING AND FIXTURES IN AUTOPSY 011 AND TOILET/SHOWER 015 TO NOT BE INSTALLED. PROVIDE PIPE WITH SHUT-OFF VALVE AND CAPS FOR FUTURE RENOVATION.
- 221120 EXISTING DOMESTIC LINE SERVING CELLS ABOVE.
- 221124 PROVIDE 2 1/2" SCW, 1 1/2" DHW, 1" DHWR FOR INFRASTRUCTURE ROUGH-IN ALTERNATE TO SERVICE FUTURE RENOVATED RESTROOM ABOVE. PROVIDE SHUT-OFF VALVE AND CAP ENDS, RUNNING PIPING UP TO FLOOR ABOVE IN LOCATION OF EXISTING EXHAUST DUCT PREVIOUSLY DEMOED AND REMOVED.
- 221128 INSTALL 3/4" DCW PIPE TO SERVE EXISTING WALL HYDRANT.
- 221136 SET GAS PRESSURE REGULATING VALVE TO 10" W.C.
- 221138 BYPASS VALVE
- 221139 REINSTALL EASY WATER WIRING TO SERVE RECIRC LINE OF WATER HEATERS.
- 221141 MANUAL BYPASS VALVE, TO BE OPENED WHEN DOMESTIC BOOSTER PUMP IS INOPERABLE.
- 221155 MAKE-UP WATER LINE FOR HOT WATER SYSTEM. REFER TO MECHANICAL SHEETS FOR CONTINUATION.
- 221156 MAKE-UP WATER LINE FOR CHILLED WATER SYSTEM. REFER TO MECHANICAL SHEETS FOR CONTINUATION.
- 221157 EXISTING DOMESTIC WATER BACKFLOW PREVENTER.
- 221158 EXISTING FIRE PROTECTION BACKFLOW PREVENTER.
- 221159 COORDINATE ROUTING OF DOMESTIC PIPING WITH ELECTRICAL EQUIPMENT IN SPACE.
- 221160 PROVIDE EMERGENCY GAS SHUTOFF

NOTE:
ELEMENTS ON THIS DRAWING ARE IDENTIFIED BY VARIOUS COLORS; IF THIS NOTE IS NOT RED, THIS DRAWING IS NOT IN COLOR AND NEEDS TO BE REPRINTED IN COLOR.

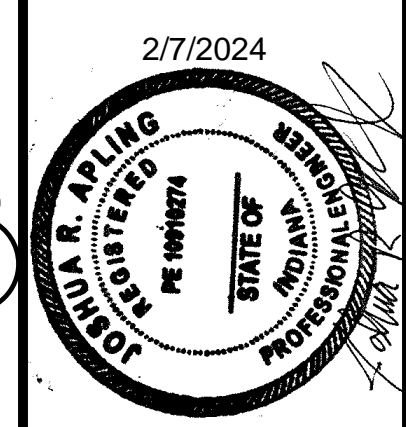

NO.	REVISION	DATE
2	ADDENDUM 4	2/7/24

DRAWN: DRWK, CHKD: JRA
DESIGNED: CRWK
APPROVD: JRA
DATE: DECEMBER 21, 2023

HANCOCK COUNTY BOARD OF COMMISSIONERS
OFFICE RENOVATIONS
123 E. MAIN STREET
PLUMBING ENLARGED PLANS - LOWER LEVEL I
PROJECT NUMBER: 2163-1063-90
DRAWING NUMBER: P4.1
PLUMBING

NOT EVERY KEYNOTE IS APPLICABLE TO EVERY SHEET

MECHANICAL KEYNOTES - MASTER INDEX

Table with 2 columns: Keynote ID and Description. Includes items like 232111 ROUTE REFRIGERANT PIPING FROM DS-1 UP THROUGH FLOOR ABOVE TO CU-1 ON ROOF.

MECHANICAL KEYNOTES - MASTER INDEX

Table with 2 columns: Keynote ID and Description. Includes items like 232304 EXISTING CHILLER AND BOILERS WILL REMAIN, REMOVE ALL HYDRONIC PIPING UP TO EQUIPMENT OR AS OTHERWISE INDICATED.

ABBREVIATIONS

Table listing abbreviations and their full names, such as AMPS AMPERES, ATC ADJUSTABLE AUTOMATIC TEMPERATURE CONTROL, etc.

GENERAL NOTES

- 1. ALL MECHANICAL WORK SHALL BE IN ACCORDANCE WITH INDIANA MECHANICAL CODE, LATEST APPLICABLE EDITION... 2. IF NON-DESIGN BASE EQUIPMENT IS SELECTED... 3. DO NOT SCALE DRAWINGS FOR DIMENSIONS...

PIPE ABBREVIATIONS

Table listing pipe abbreviations and their full names, such as CHILLED WATER RETURN, COMBUSTION FLUE, etc.

Table titled 'HVAC BASIS OF DESIGN' showing conditions for Summer (Outdoor 91°F DB, 75°F WB) and Winter (Outdoor 3°F DB, 70°F DB).

SYMBOLS

Table of symbols for mechanical components, including rectangular duct dimension, round duct dimension, supply/return air ducts, diffusers, valves, and sensors.

GENERAL DEMOLITION NOTES

- 1. REFER TO DRAWINGS OF ALL OTHER DISCIPLINES FOR ADDITIONAL REMOVALS AND SELECTIVE DEMOLITION ACTIVITIES... 2. CONTRACTOR SHALL FIELD VERIFY ALL EXISTING CONDITIONS AND DIMENSIONS PRIOR TO SELECTIVE DEMOLITION ACTIVITIES...

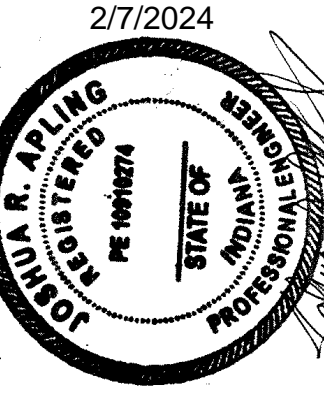



Table with columns for DATE (2/7/24), REVISION (2), and NO.

Table with columns for DRAWING, DESIGNED, APPROVED, DATE, and PROJECT NUMBER (2103-1063-90).

HANCOCK COUNTY BOARD OF COMMISSIONERS OFFICE RENOVATIONS 123 E. MAIN STREET GENERAL INFORMATION

DRAWING NUMBER M0.1 MECHANICAL

C:\Rev\Backups\2022\163-1063-90_Hancock Co_Jail_Mech_sstains_dtz.rvt
2/6/2024 4:18:48 PM

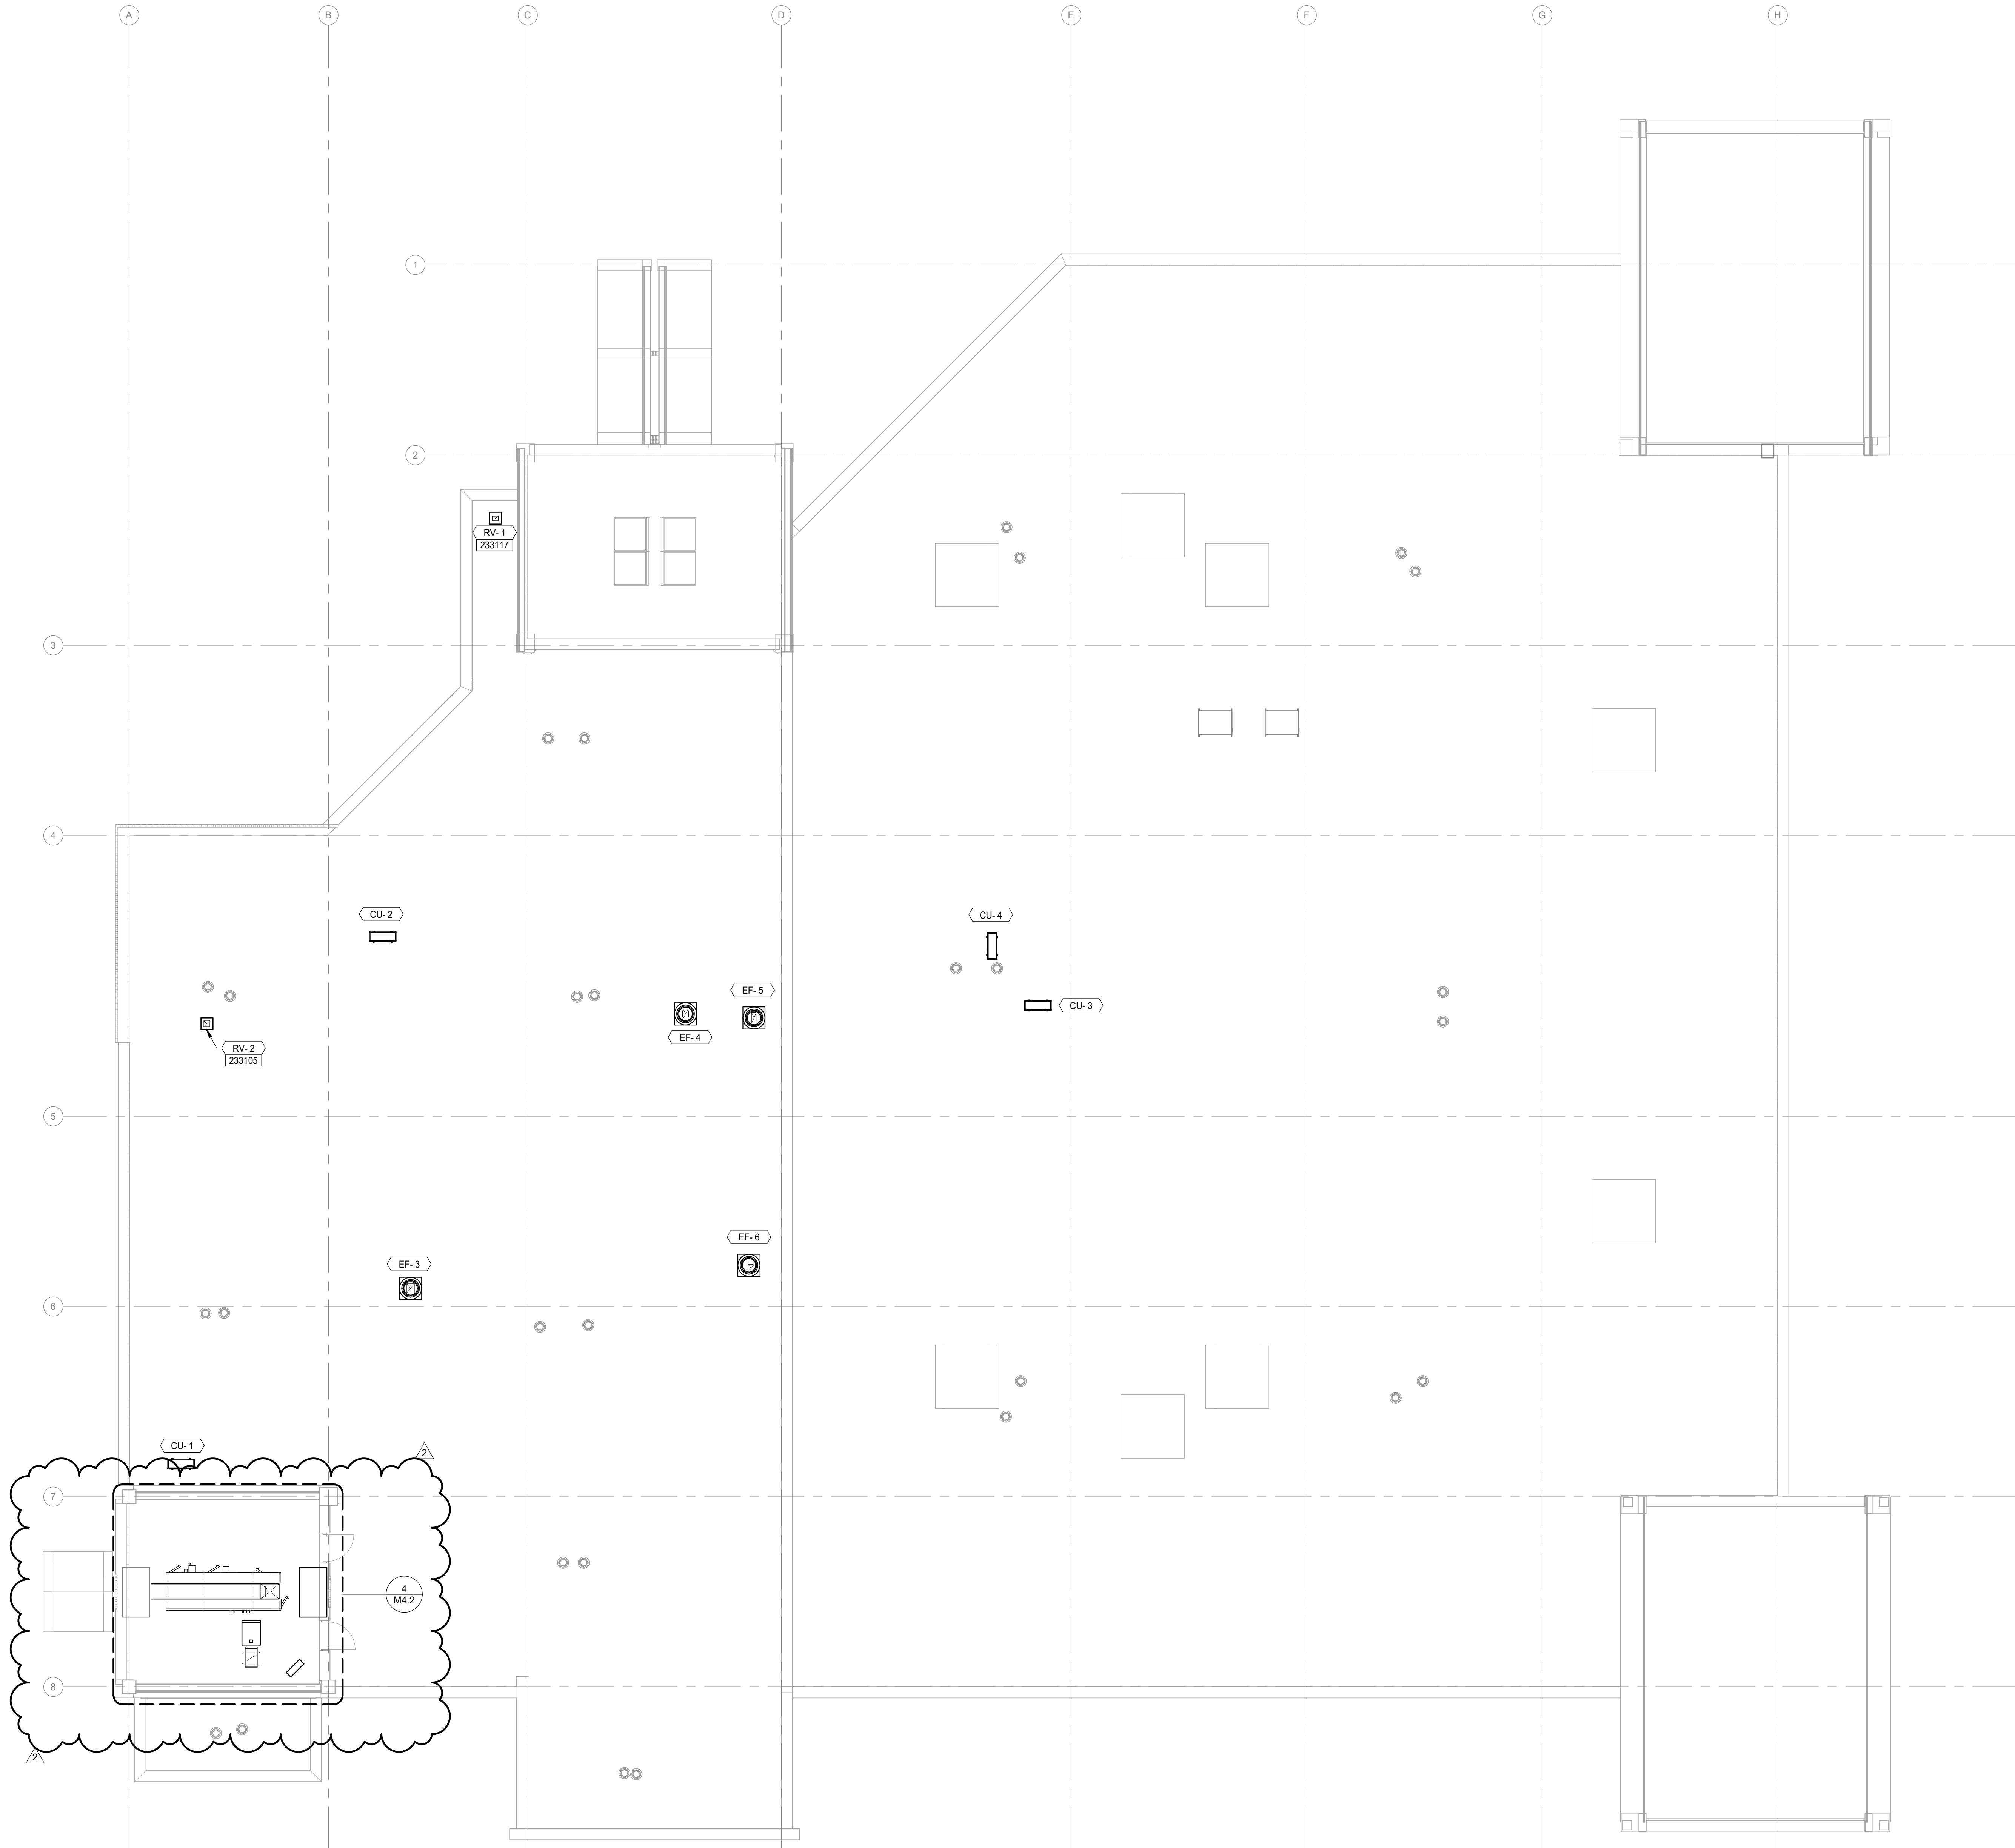



1 ROOF DUCTWORK INSTALLATION PLAN
SCALE: 1/8" = 1'-0"
NORTH

GENERAL NOTES

- A. REFER TO SHEETS G-1.1 AND M0.1 FOR ADDITIONAL GENERAL NOTES AND INFORMATION.
- B. DUCT AND PIPING LAYOUTS ARE SCHEMATIC IN NATURE. PROVIDE ADDITIONAL TRANSITIONS, ELBOWS, OFFSETS, AND FITTINGS AS REQUIRED.
- C. COORDINATE ALL WORK WITH OTHER TRADES TO PERMIT ACCESS AND SERVICE CLEARANCES TO ALL SYSTEMS. COORDINATE DUCT WITH ELECTRICAL J-BOXES TO PREVENT OBSTRUCTIONS.
- D. COORDINATE ANY STRUCTURAL SUPPORTS FOR OPENINGS WITH STRUCTURAL TRADES.
- E. DO NOT SCALE DRAWINGS FOR DIMENSIONS. REFER TO ARCHITECTURAL DIMENSIONED DRAWINGS.
- F. REFER TO DETAIL SHEETS FOR ADDITIONAL INFORMATION ON INSTALLMENT METHODS.
- G. DEVIATIONS FROM BASIS OF DESIGN THAT AFFECT OTHER TRADES ARE THE RESPONSIBILITY OF THIS CONTRACTOR. ADDITIONAL COSTS TO PROVIDE LARGER ELECTRICAL CIRCUITS, MORE FLOOR SPACE, ADDITIONAL SUPPORTS, ADDITIONAL MATERIAL, ETC. SHALL BE BORNE BY THIS CONTRACTOR. COORDINATE ALL WORK WITH OTHER TRADES.
- H. PIPING TO INDIVIDUAL VAV BOXES IS 3/4" UNLESS NOTED OTHERWISE.

KEYNOTES


- 233105 ROUTE 8"X8" EXHAUST DUCT UP THROUGH EXISTING ROOF PENETRATION FROM EF-2 INTO RV-2. FIELD VERIFY LOCATION.
- 233117 ROUTE 8"X8" EXHAUST DUCT UP THROUGH EXISTING ROOF PENETRATION FROM EF-1 INTO RV-1. FIELD VERIFY LOCATION.

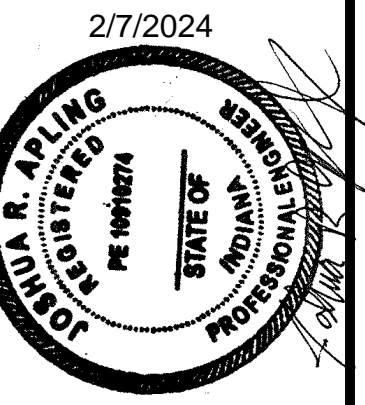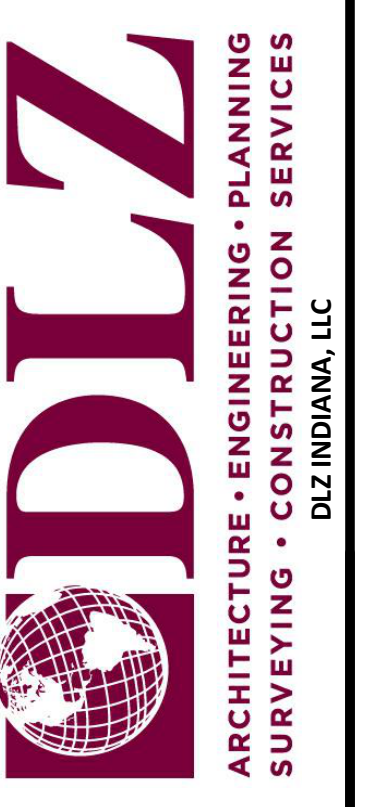

DATE	2/7/24
REVISION	
NO.	2
DESCRIPTION	ADDENDUM 4
DRAWN: SPS	CHKD: JRA
DESIGNED: SPS	APPRVD: JRA
DATE: DECEMBER 21, 2023	
PROJECT NUMBER	2163-1063-90

HANCOCK COUNTY BOARD OF COMMISSIONERS
OFFICE RENOVATIONS
123 E. MAIN STREET
ROOF MECHANICAL DUCTWORK PLAN

DRAWING NUMBER
M1.2
MECHANICAL

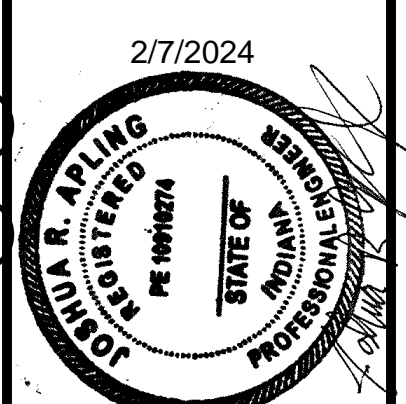

DATE	2/7/24
REVISION	
NO.	2 - ADDENDUM 4
CHKD:	JRA
DESIGNED:	SFS
APPROVD:	JRA
DATE:	DECEMBER 21, 2023
PROJECT NUMBER	2163-1063-90

HANCOCK COUNTY BOARD OF COMMISSIONERS
OFFICE RENOVATIONS
MECHANICAL ROOMS ENLARGED PLANS


DRAWING NUMBER	M4.2
MECHANICAL	

GENERAL NOTES


- A. REFER TO SHEETS G1.1 AND M0.1 FOR ADDITIONAL GENERAL NOTES AND INFORMATION.
- B. DUCT AND PIPING LAYOUTS ARE SCHEMATIC IN NATURE. PROVIDE ADDITIONAL TRANSITIONS, ELBOWS, OFFSETS, AND FITTINGS AS REQUIRED.
- C. COORDINATE ALL WORK WITH OTHER TRADES TO PERMIT ACCESS AND SERVICE CLEARANCES TO ALL SYSTEMS. COORDINATE DUCT WITH ELECTRICAL J-BOXES TO PREVENT OBSTRUCTIONS.
- D. COORDINATE ANY STRUCTURAL SUPPORTS FOR OPENINGS WITH STRUCTURAL TRADES.
- E. DO NOT SCALE DRAWINGS FOR DIMENSIONS. REFER TO ARCHITECTURAL DIMENSIONED DRAWINGS.
- F. REFER TO DETAIL SHEETS FOR ADDITIONAL INFORMATION ON INSTALLMENT METHODS.
- G. DEVIATIONS FROM BASIS OF DESIGN THAT AFFECT OTHER TRADES ARE THE RESPONSIBILITY OF THIS CONTRACTOR. ADDITIONAL COSTS TO PROVIDE LARGER ELECTRICAL CIRCUITS, MORE FLOOR SPACE, ADDITIONAL SUPPORTS, ADDITIONAL MATERIAL, ETC. SHALL BE BORNE BY THIS CONTRACTOR. COORDINATE ALL WORK WITH OTHER TRADES.
- H. PIPING TO INDIVIDUAL VAV BOXES IS 3/4" UNLESS NOTED OTHERWISE.

KEYNOTES


- 230007 REUSE AND EXTEND EXISTING CONCRETE PADS IF POSSIBLE FOR NEW MECHANICAL EQUIPMENT IN SIMILAR LOCATION TO EXISTING. VERIFY CLEARANCES OF EQUIPMENT.
- 230009 REMOVE AND REINSTALL EXISTING LOUVER AS NEEDED FOR INSTALLATION OF AHU-4 IN PENTHOUSE. EXISTING RELIEF AIR PLENUM TO BE REMOVED AND REINSTALLED AS NEEDED. INSTALL 20"x24" BACKDRAFT DAMPER IN PLENUM.
- 230011 CONNECT NEW OA DUCTWORK TO EXISTING PLENUM.
- 232107 MAKE UP WATER LINE. SEE PLUMBING DRAWINGS FOR CONTINUATION.
- 233121 REMOVE BACKDRAFT DAMPER FROM THE LOUVER PLENUM AND PROVIDE A NEW DAMPER.
- 233138 PROVIDE UNITS WITH EXISTING REPROGRAMMED AON VCOX2 CONTROLLERS. CONTROLLERS SHALL BE REPROGRAMMED TO MEET NEW SEQUENCE OF OPERATION FOR THE UNITS AS PER SHEETS M7.X SERIES
- 233150 RUN WATER HEATER COMBUSTION AIR THROUGH SIDEWALL OF MECHANICAL ROOM. INSTALL PER MANUFACTURERS RECOMENDATION.
- 233152 RUN WATER HEATER EXHAUST AIR THROUGH SIDEWALL OF MECHANICAL ROOM. INSTALL PER MANUFACTURERS RECOMENDATION.
- 233164 PROVIDE EMERGENCY BOILER SHUTDOWN SWITCH TIED TO GAS SOLENOID

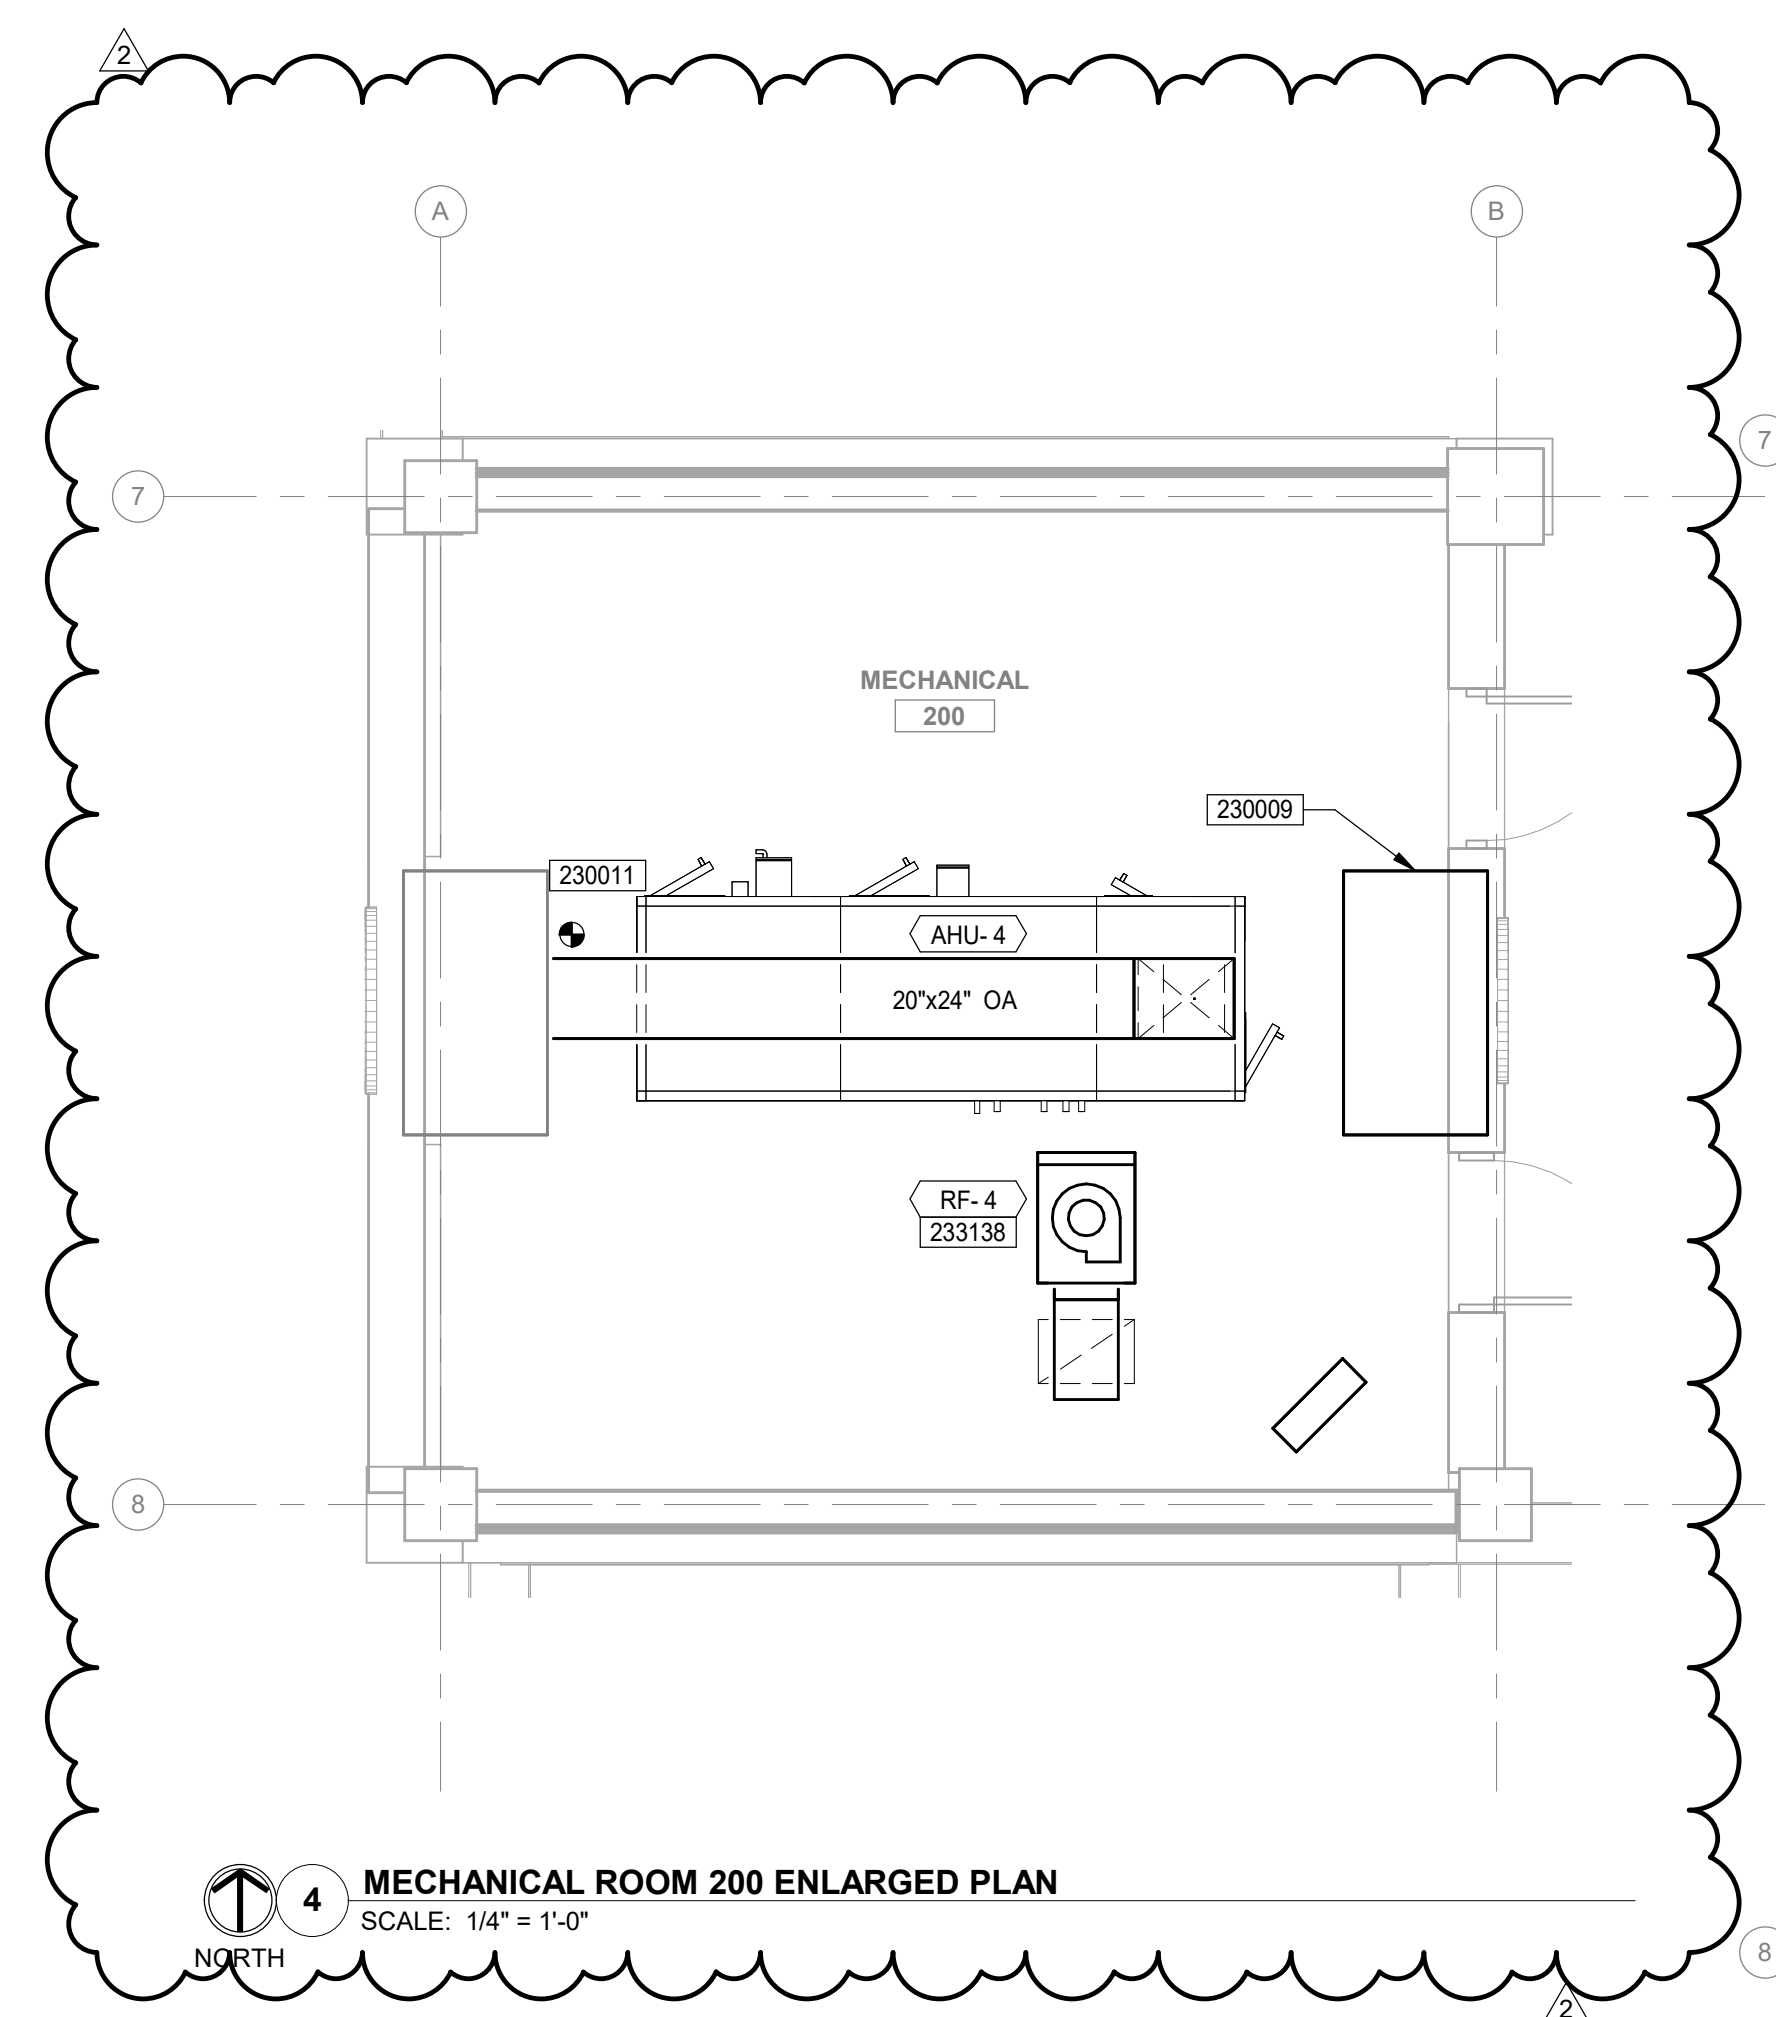


4 MECHANICAL ROOM 200 ENLARGED PLAN
 SCALE: 1/4" = 1'-0"

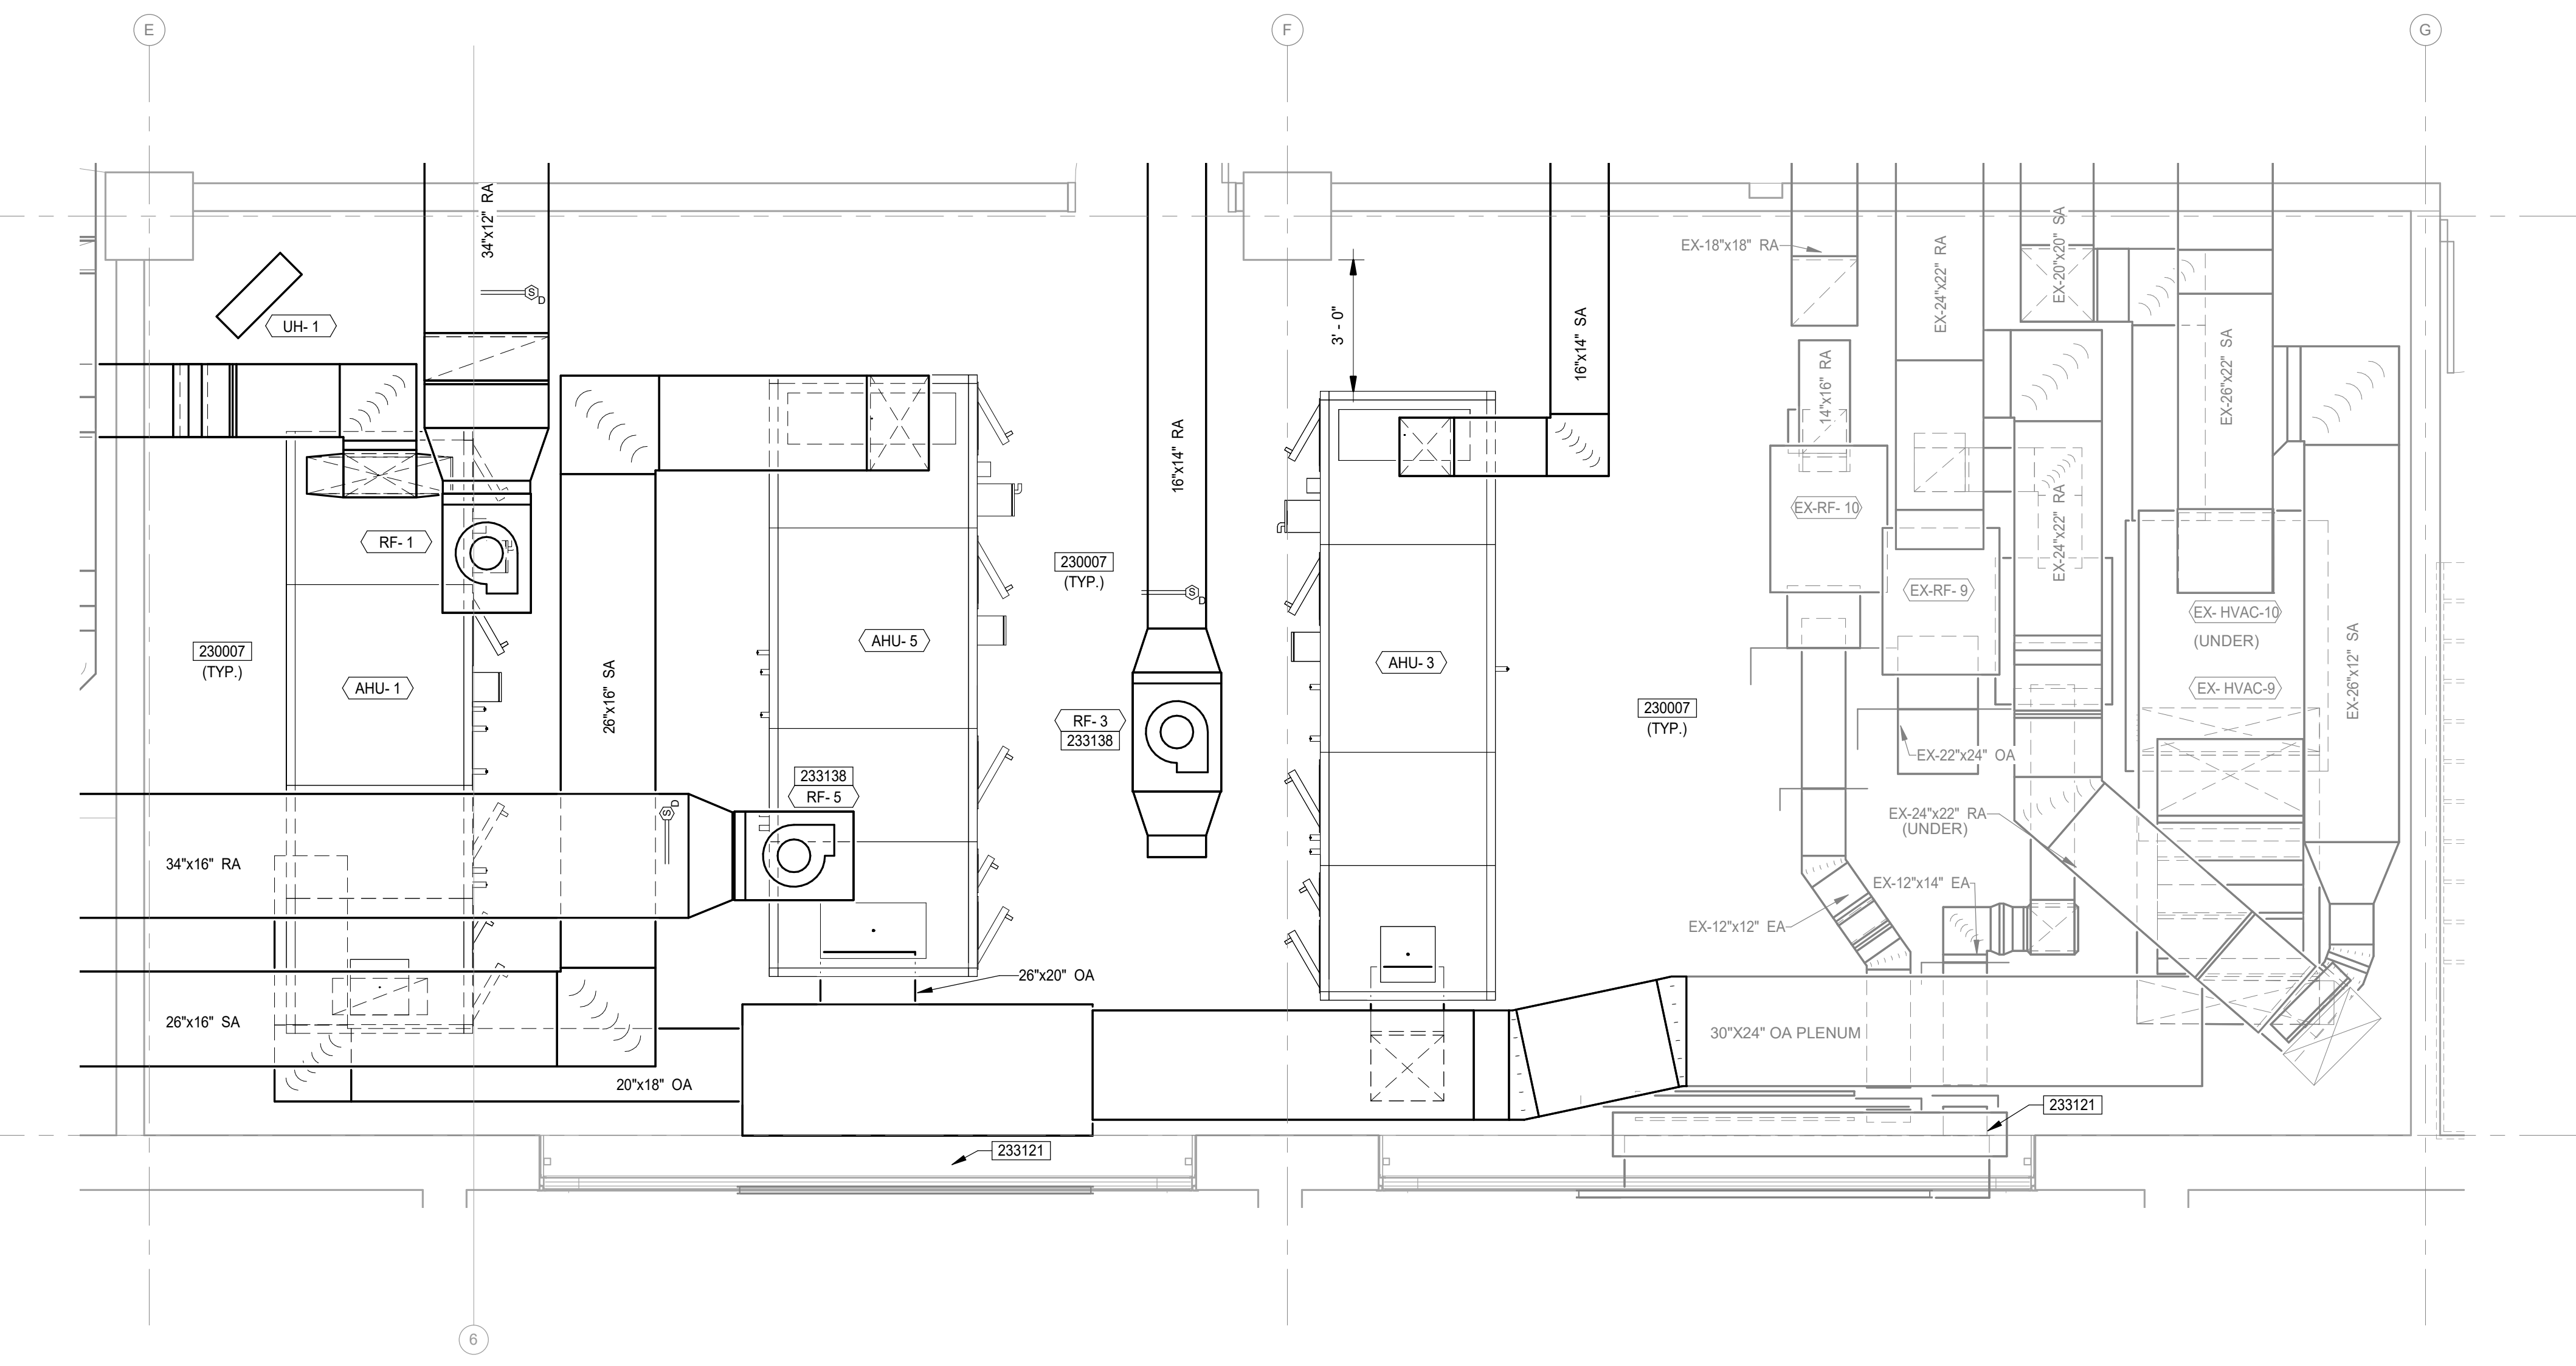


1 MECHANICAL ROOM 008 ENLARGED PLANS
 SCALE: 3/8" = 1'-0"

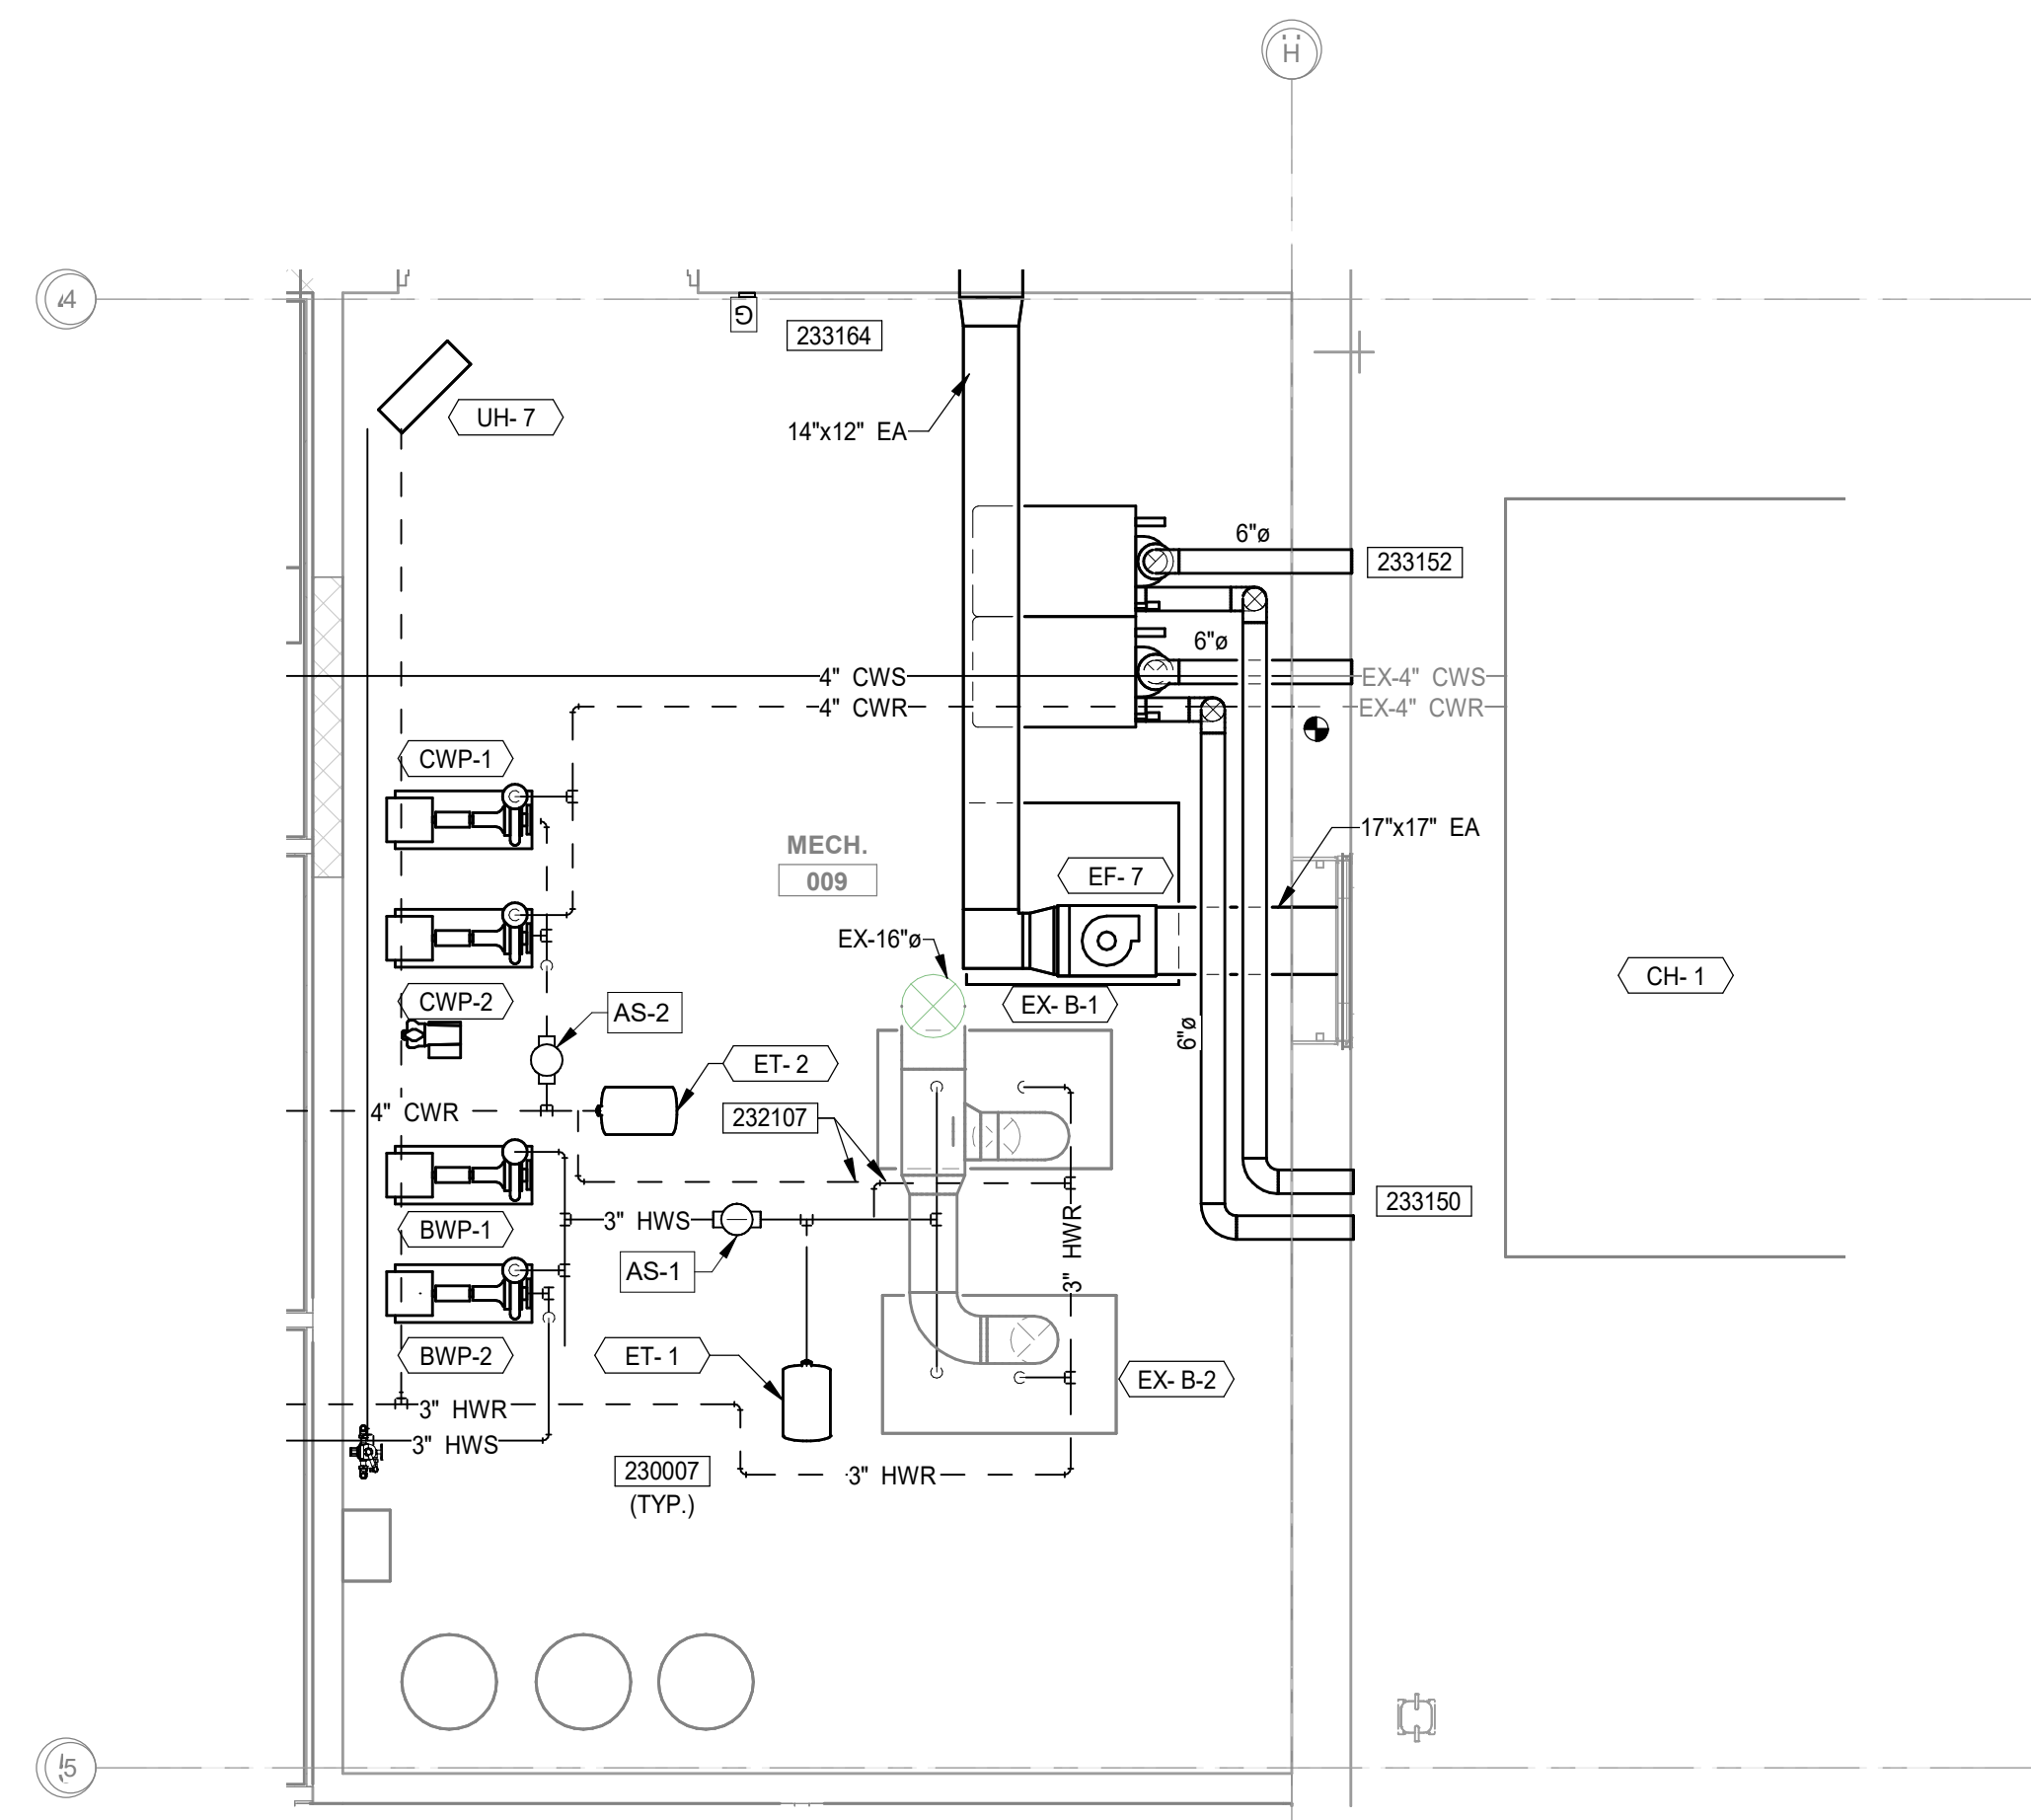


3 MECHANICAL ROOM 014 ENLARGED PLAN
 SCALE: 1/4" = 1'-0"

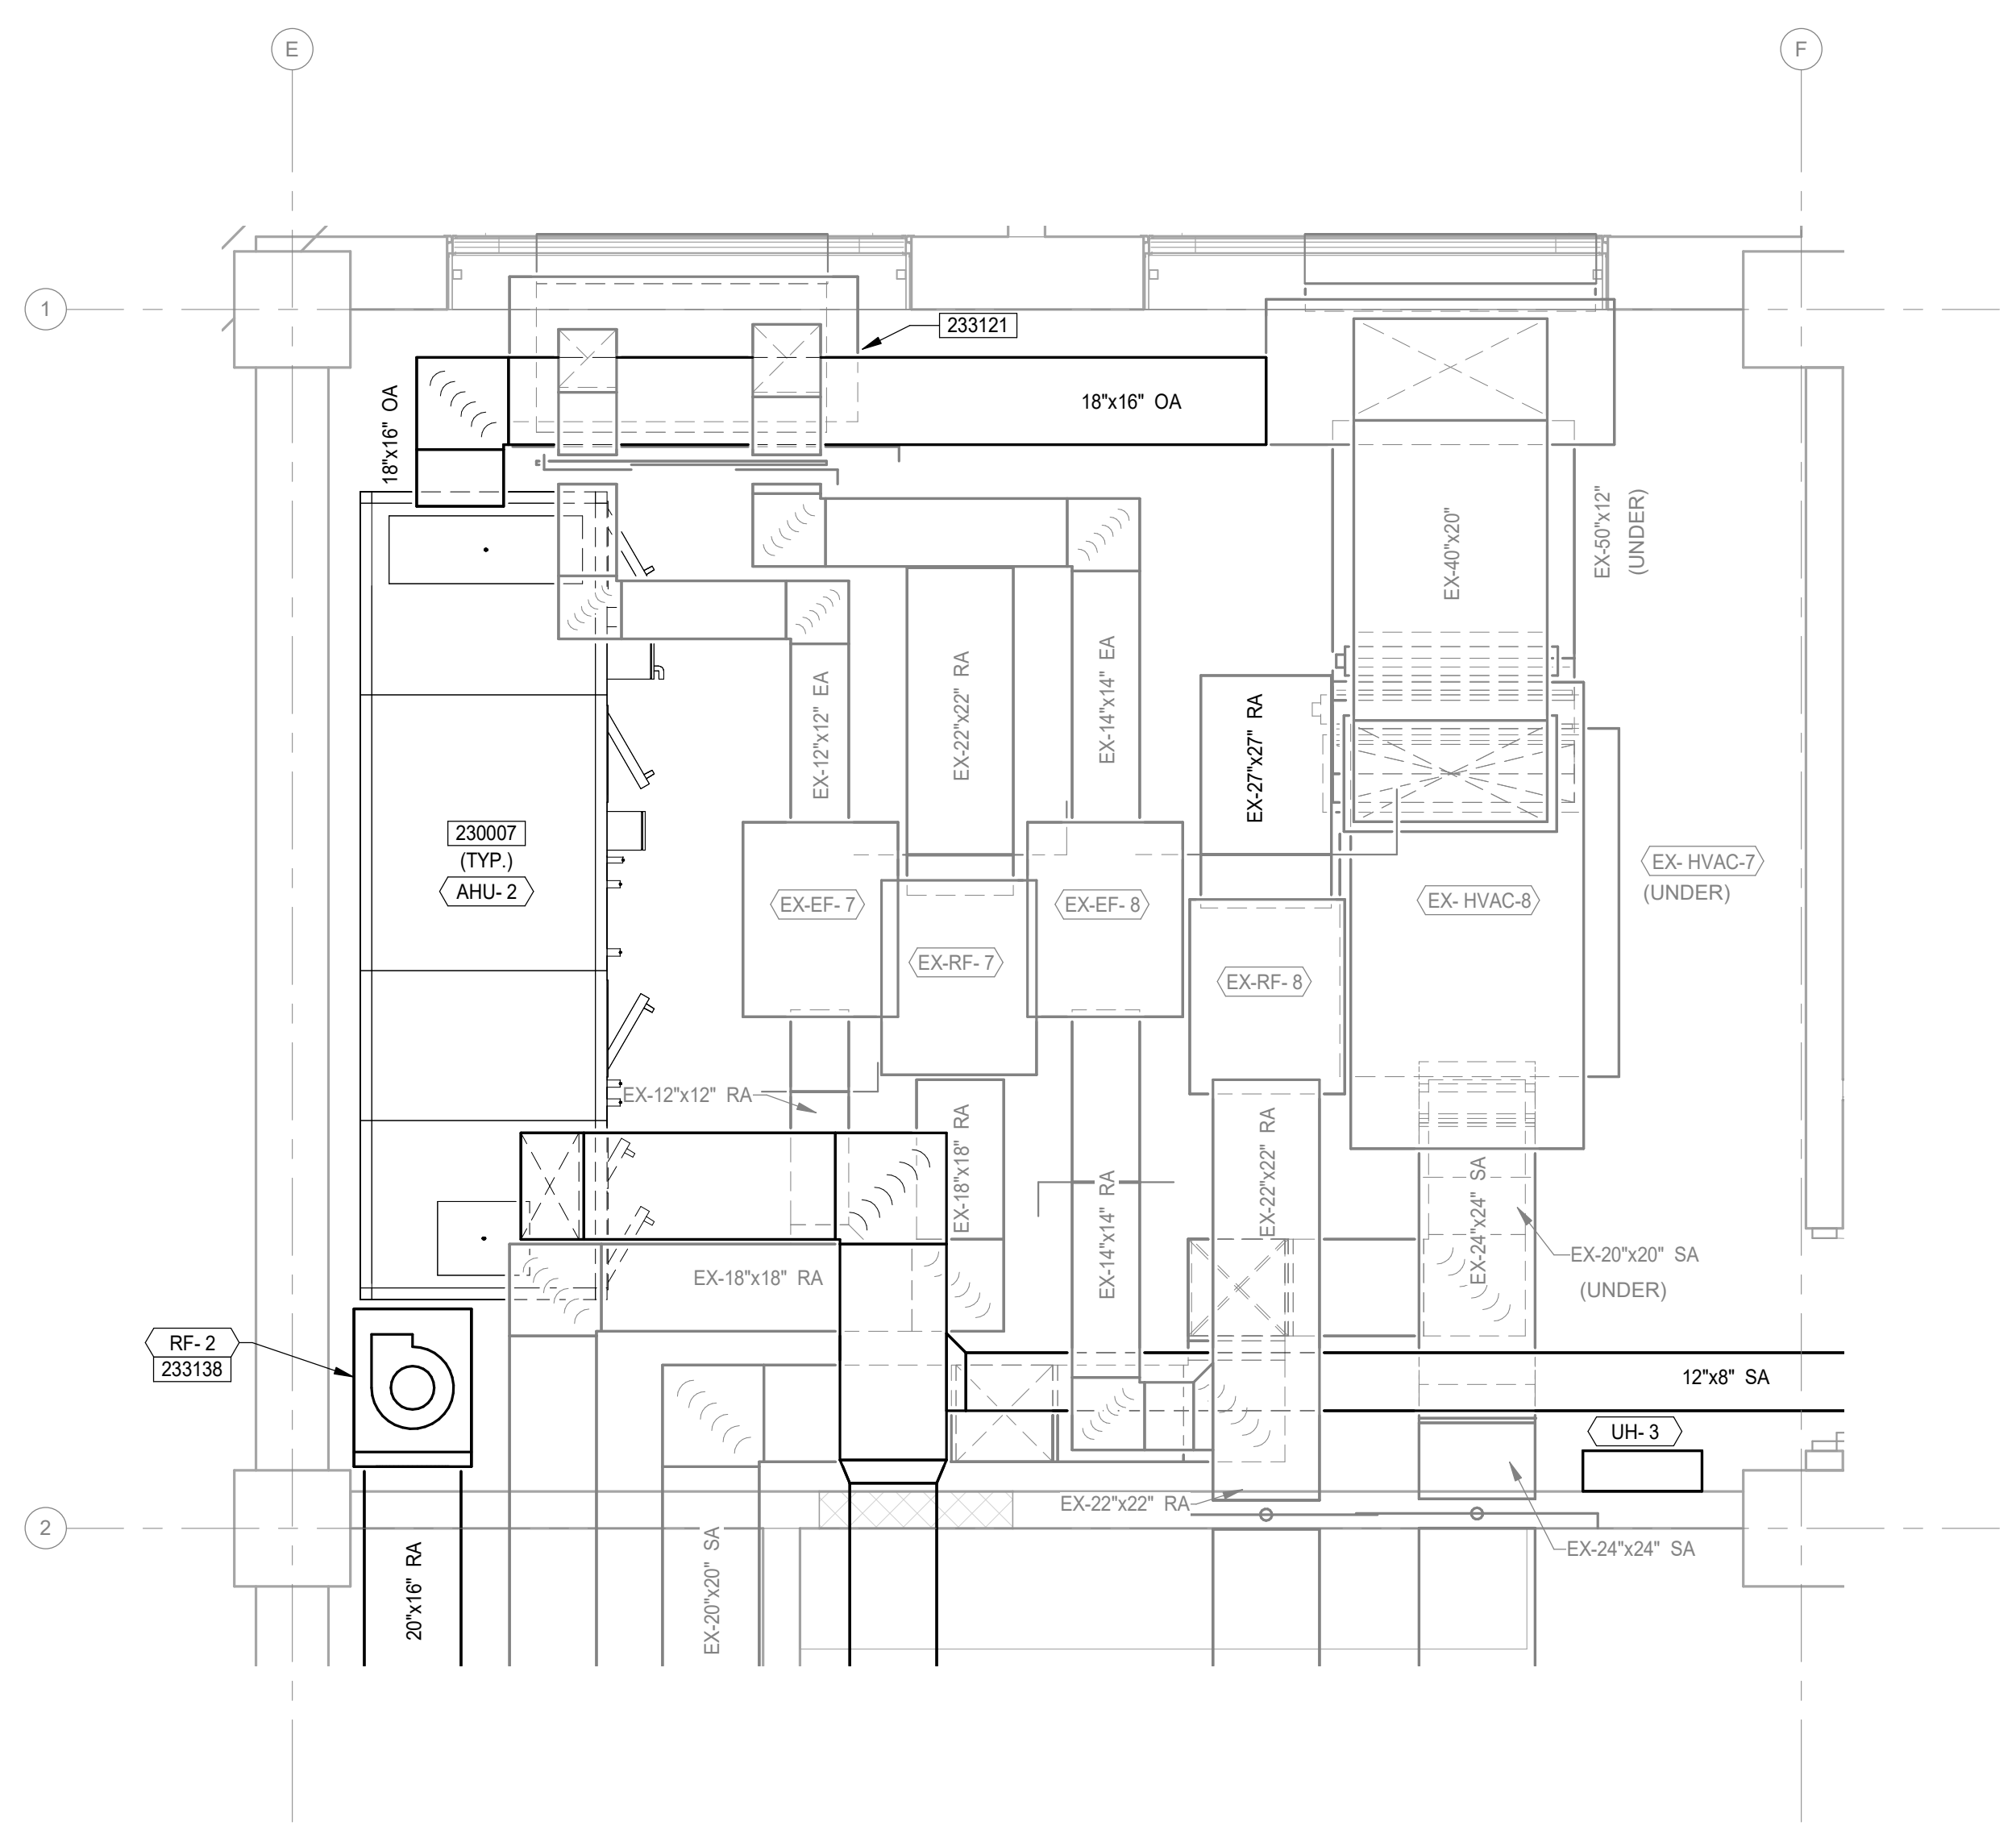


2 MECHANICAL ROOM 019 ENLARGED PAN
 SCALE: 3/8" = 1'-0"

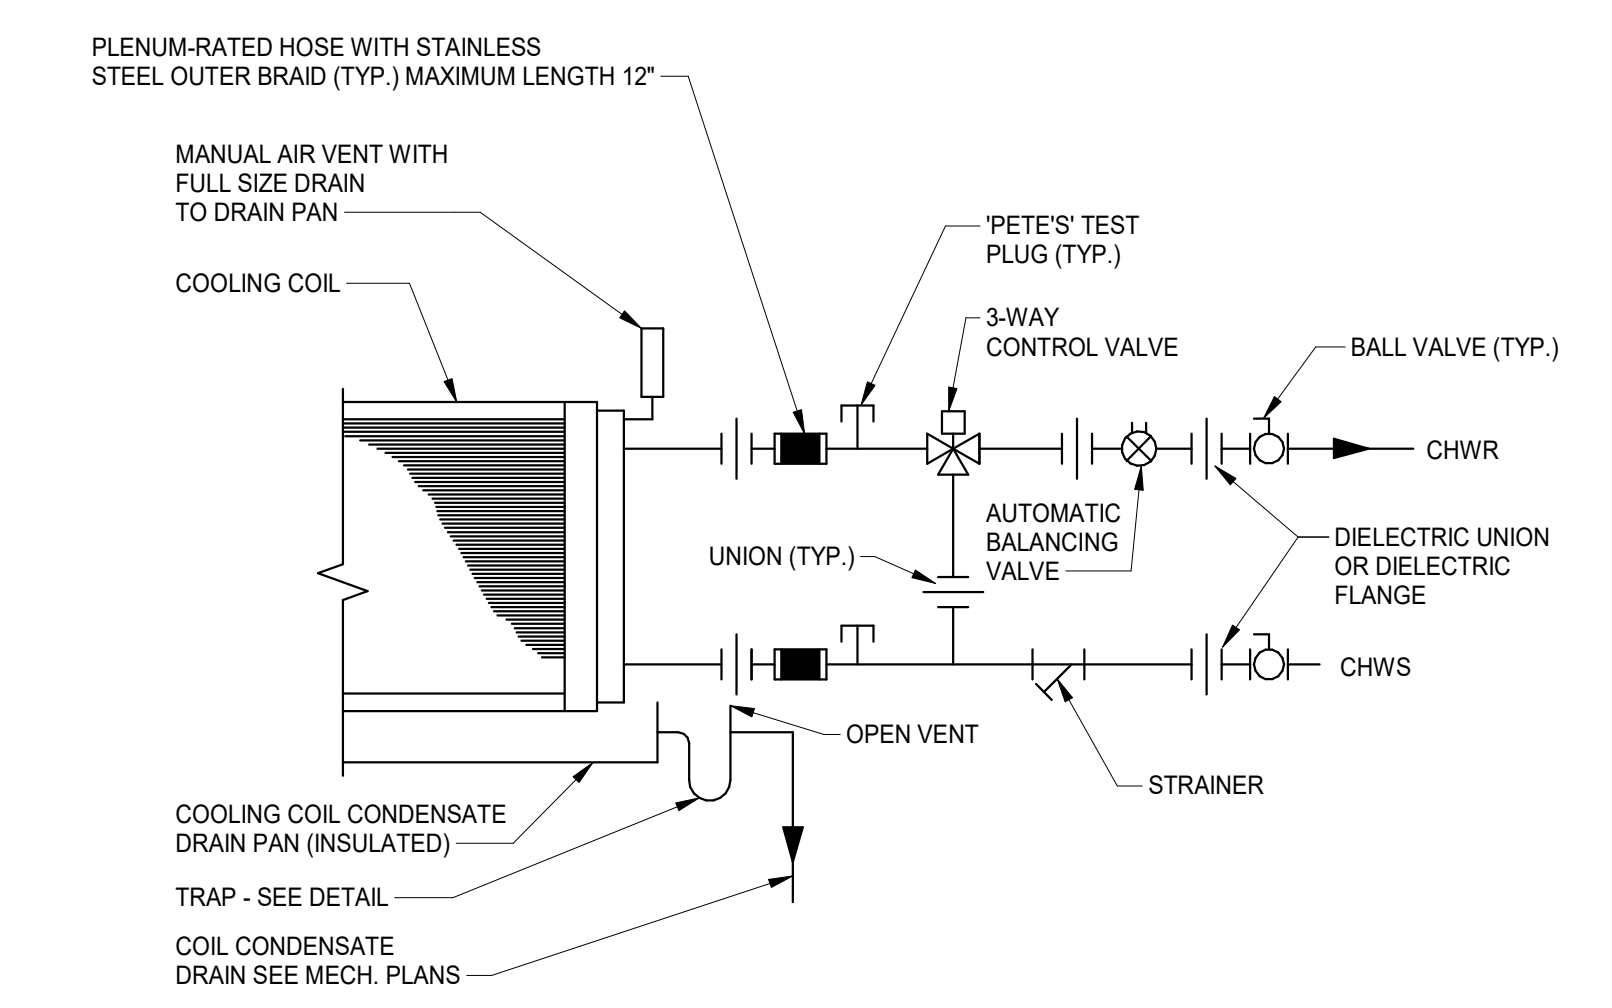


4 AIR HANDLING UNIT COIL PIPING DETAIL (3-WAY)
 SCALE: N.T.S.

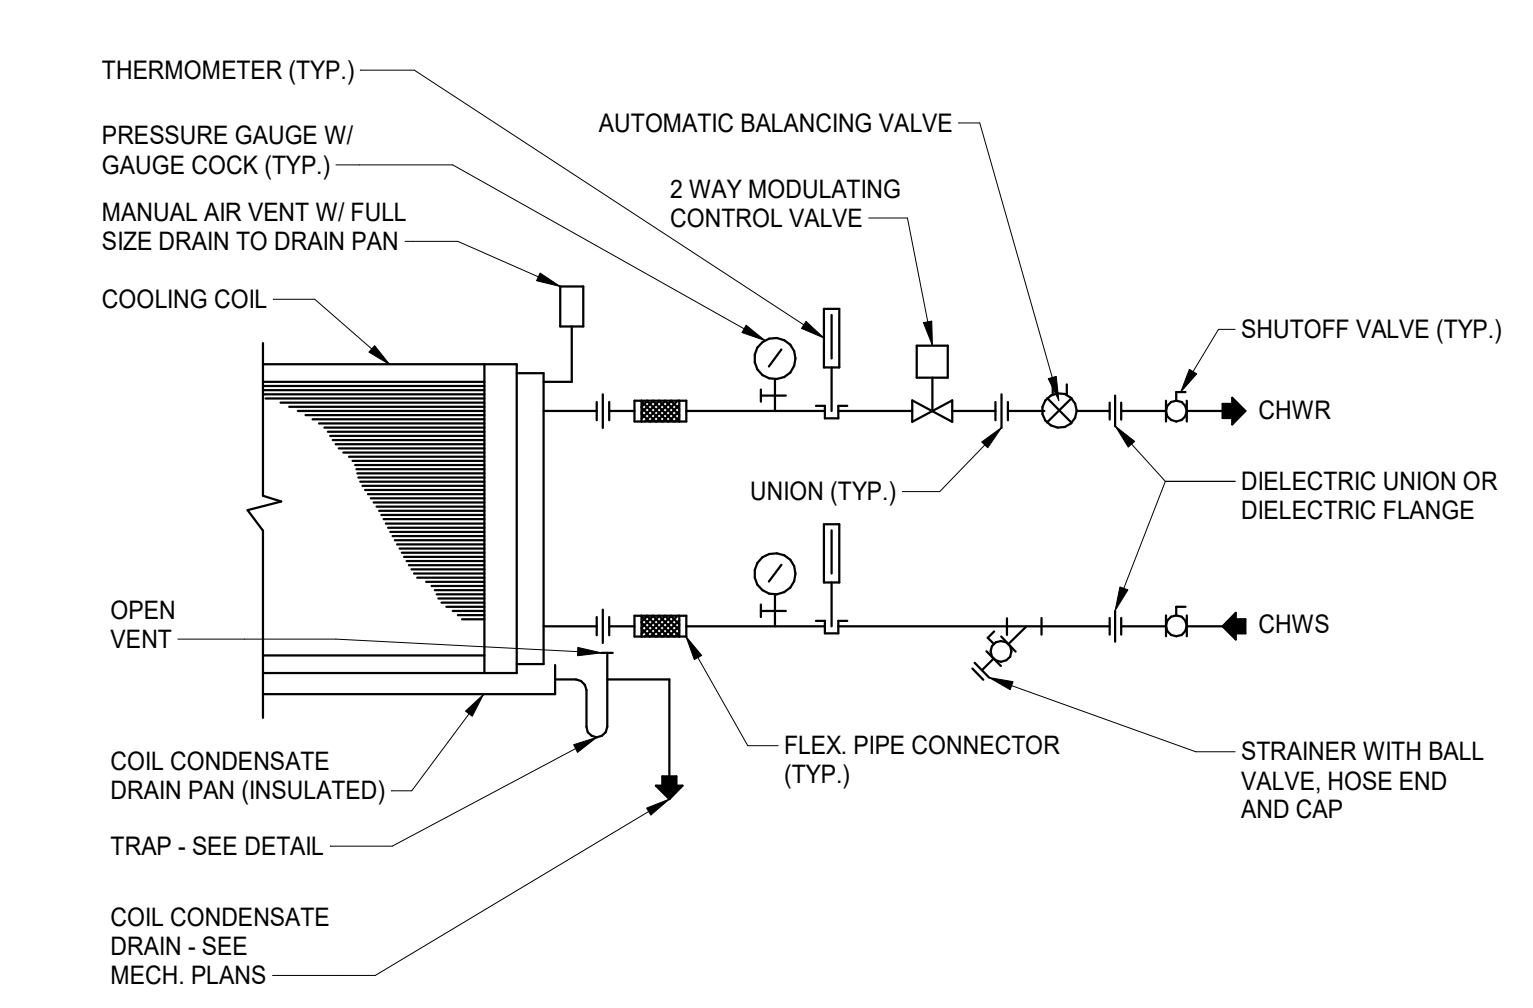

3 AIR HANDLING UNIT COIL PIPING DETAIL (2-WAY)
 SCALE: N.T.S.

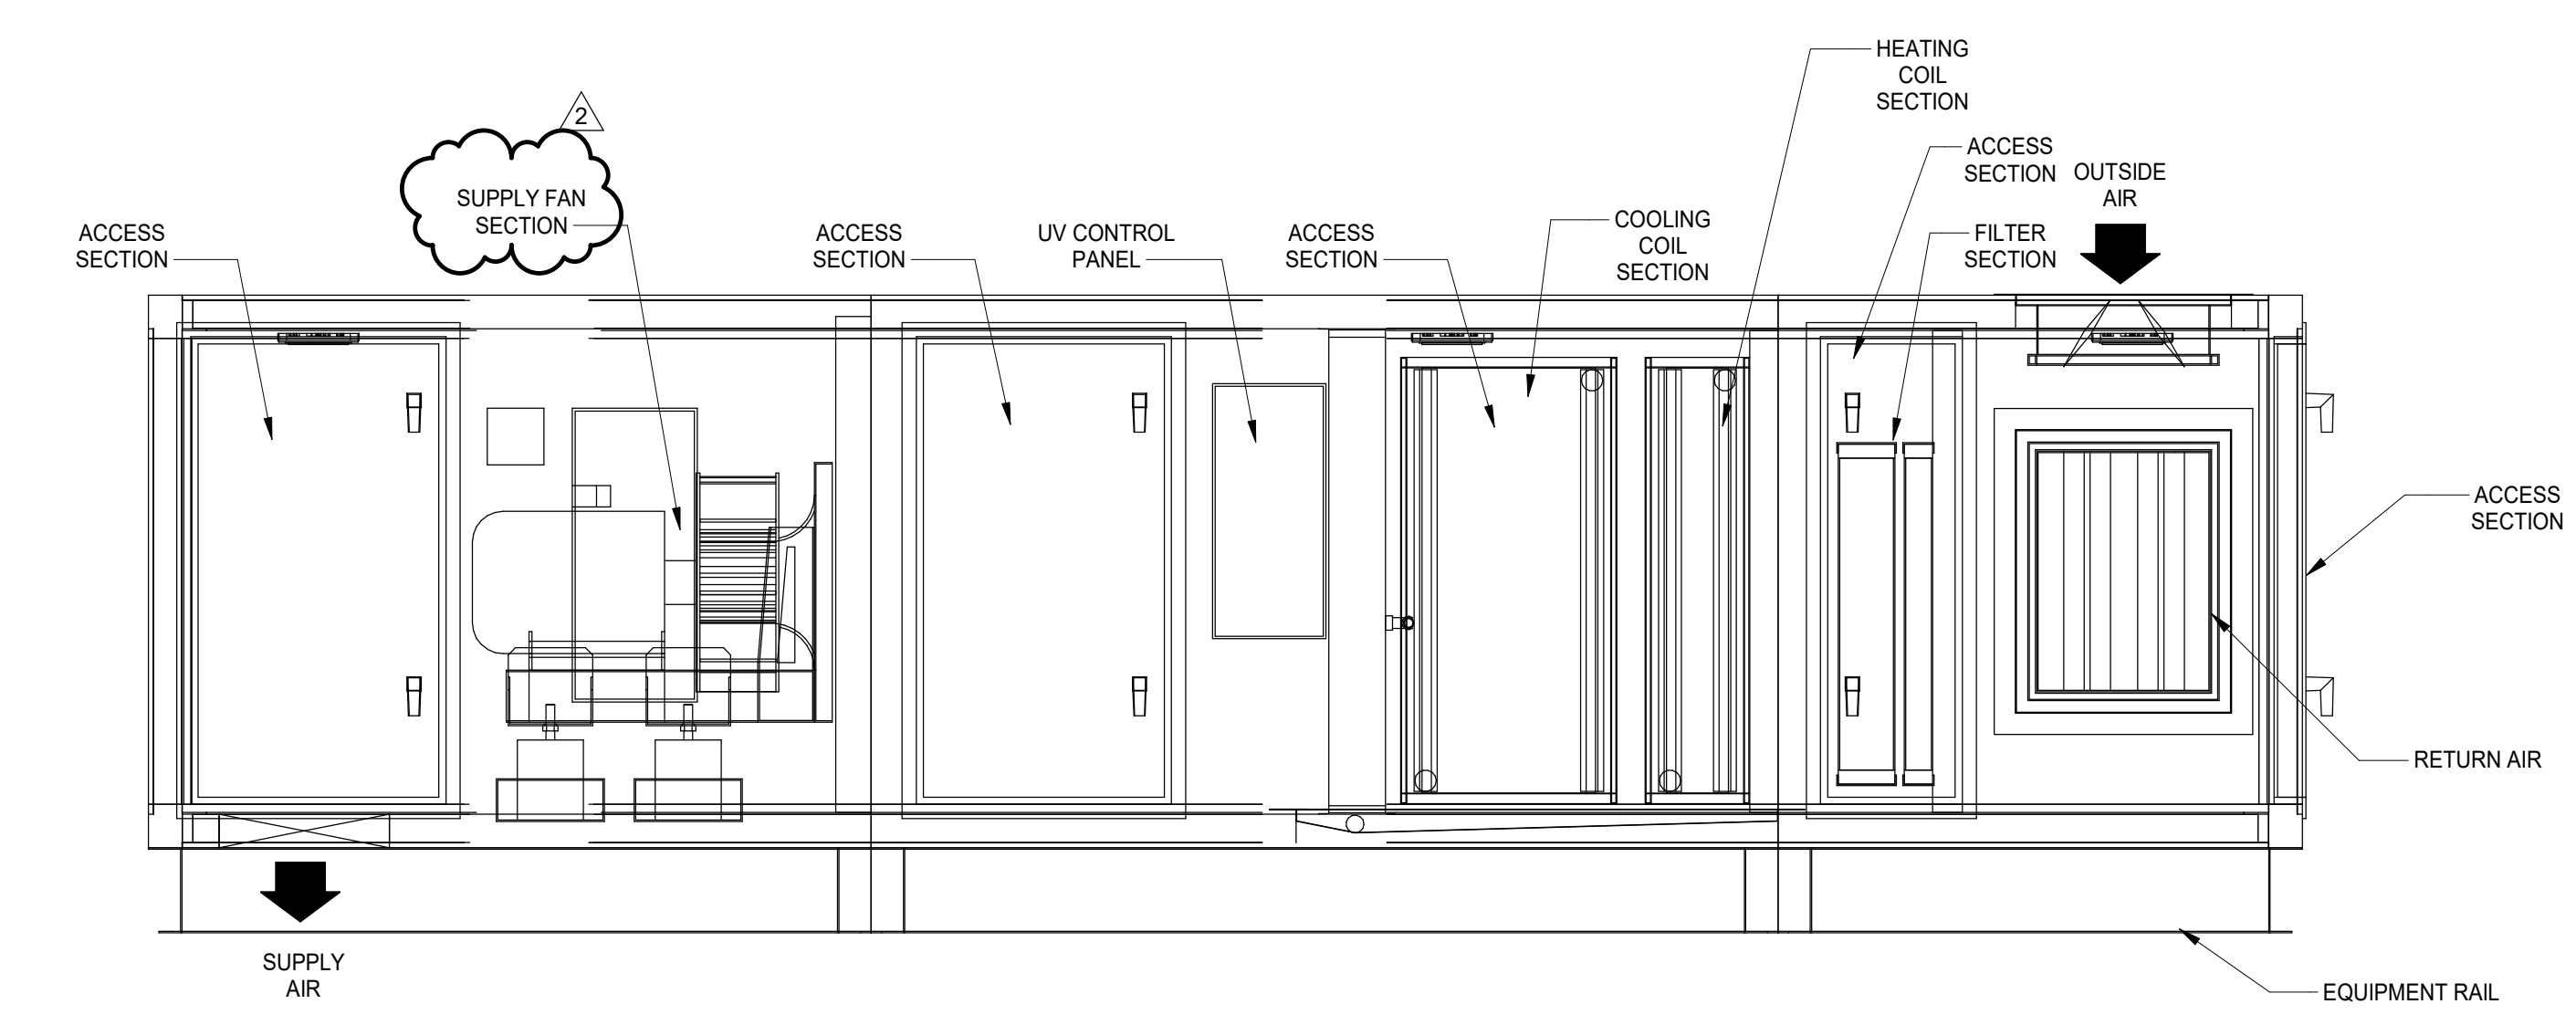

2 AHU-4 SECTION
 SCALE: N.T.S.

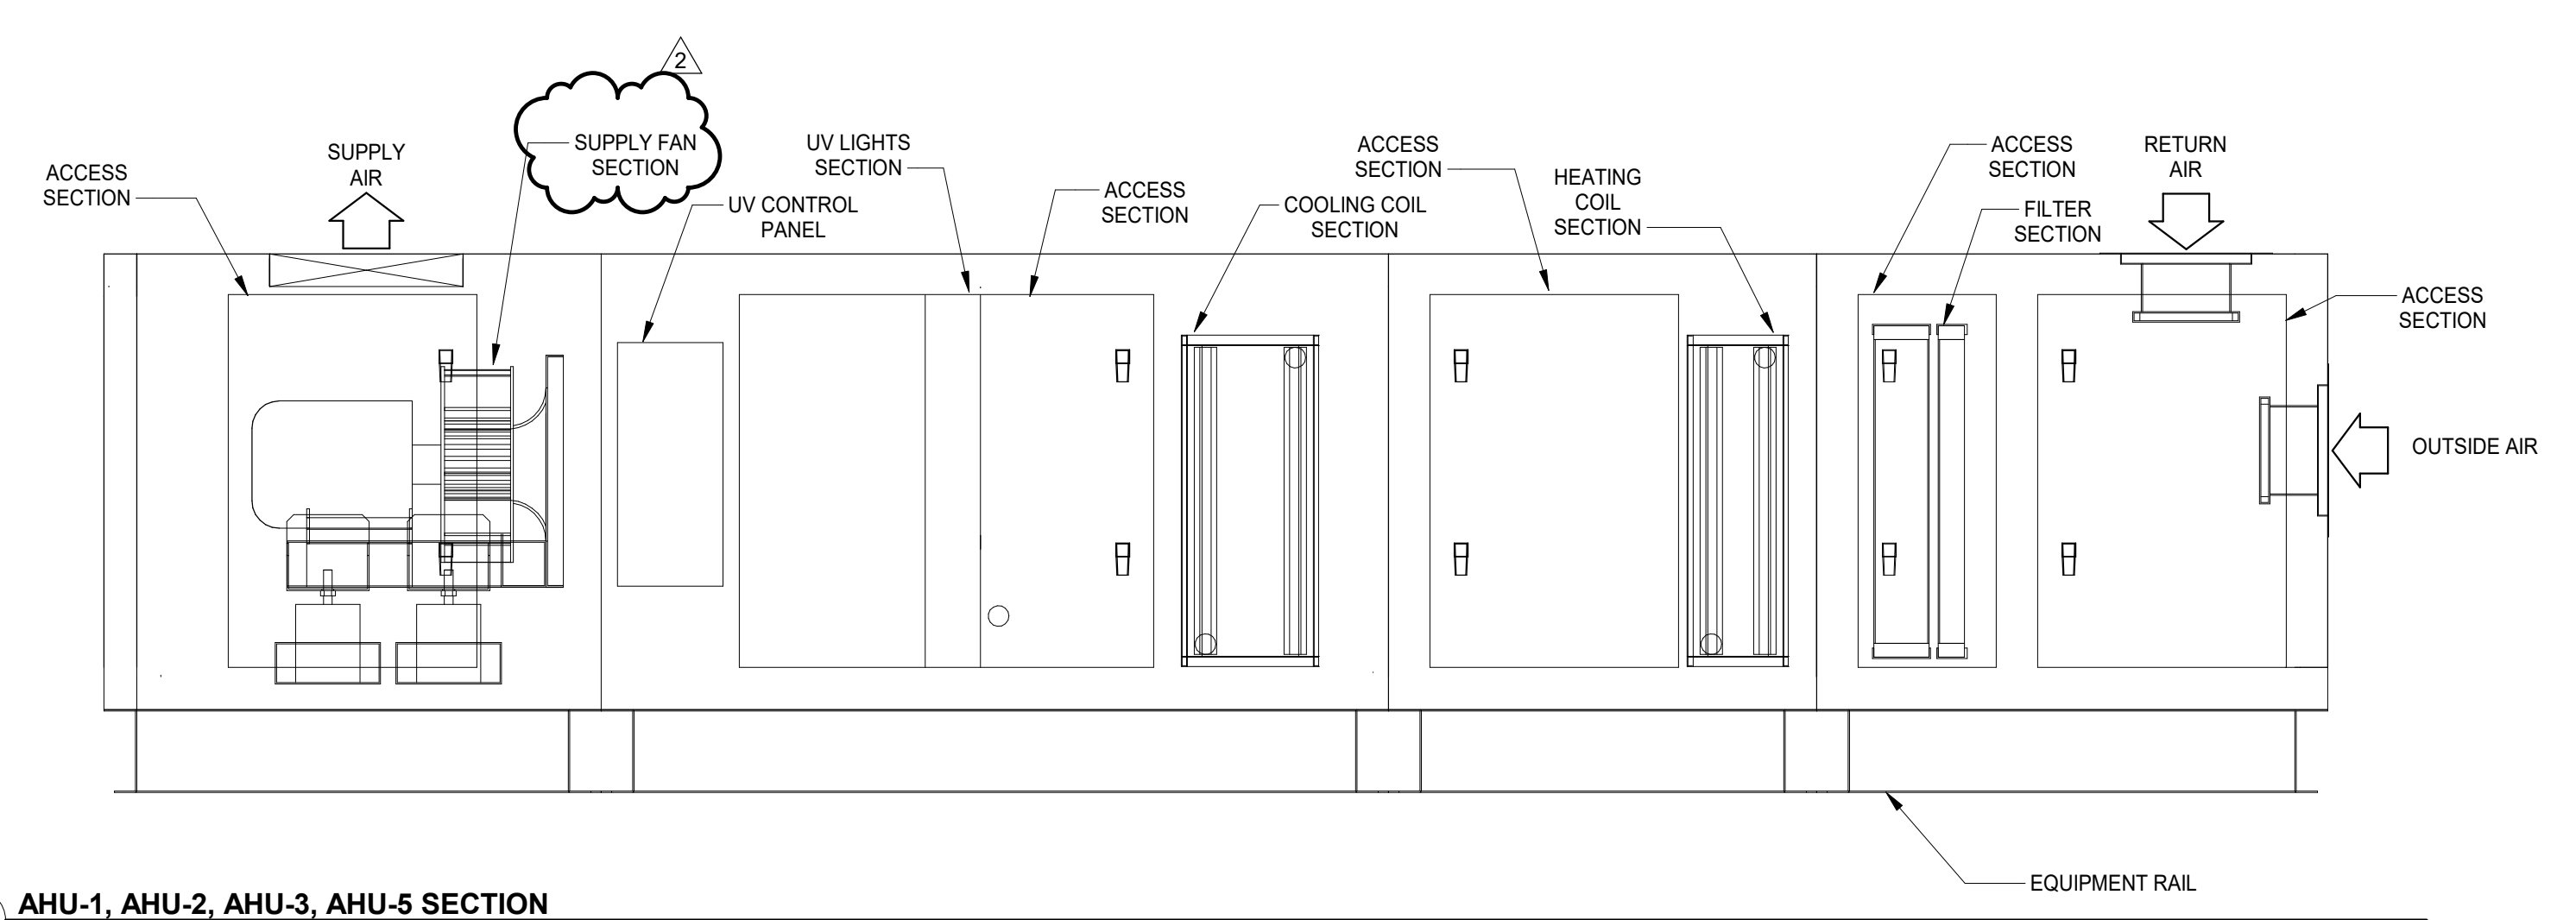

1 AHU-1, AHU-2, AHU-3, AHU-5 SECTION
 SCALE: N.T.S.

DATE	2/7/24
REVISION	2 - ADDENDUM 4
NO.	2
CHKD: JRA	
DESIGNED: SPS	
APPRVD: JRA	
DATE:	DECEMBER 21, 2023
PROJECT NUMBER	2163-1063-90

HANCOCK COUNTY BOARD OF COMMISSIONERS
 OFFICE RENOVATIONS
 123 E. MAIN STREET
 MECHANICAL DETAILS - III

DRAWING NUMBER	M5.3
MECHANICAL	

INDOOR AIR HANDLING UNIT SCHEDULE table with columns: TAG, MANUFACTURER, MODEL, QUANTITY, SUPPLY FAN (CFM, E.S.P., TSP, MIN O.A.), ELECTRICAL (VOLT/PH, MAX UNIT AMPS, FAN HP, BHP, ROW QUANTITY, E.A.T., L.A.T., CAPACITY), COOLING COIL (WATER PRESSURE, FLUID TYPE, CAPACITY, CFM, EAT/LAT, ROW QUANTITY, FINN PER FEET), HEATING COIL (WATER TEMPERATURE, WATER FLOW, WATER PRESSURE), OVERALL HEIGHT, OVERALL LENGTH, OVERALL WIDTH, WEIGHT, NOTES.

NOTES: 1. UNIT IS AN INDOOR RATED, CUSTOM UNIT. 2. REFER TO DETAIL 1M7.2 FOR CONTROLS. 3. MANUFACTURER TO PROVIDE SUPPLY FAN VFDs AND STARTER DISCONNECT AS PER DIVISION 26 SPECIFICATIONS. 4. PROVIDE 3-WAY VALVES FOR HYDRONIC HOT WATER COIL. REFER TO DETAIL 4M5.3. 5. PROVIDE 3-WAY VALVES FOR HYDRONIC CHILLED WATER COIL. REFER TO DETAIL 4M5.3. 6. PROVIDE 2-WAY VALVES FOR HYDRONIC CHILLED WATER COIL. REFER TO DETAIL 3M5.3. 7. CONTRACTOR TO DISASSEMBLE AIR-HANDLING UNIT SECTIONS IN THE FIELD AS NEEDED TO FIT THROUGH DOORWAYS IN ROUTE TO INSTALLATION LOCATION OF UNIT. COORDINATE WITH THE MANUFACTURER DURING BIDDING PROCESS THE REQUIREMENTS.

RETURN FAN SCHEDULE table with columns: TAG, MANUF., MODEL, CFM, E.S.P. (IN. WC), HP, VOLT., PH., EQUIPMENT SERVED, NOTES.

NOTES: 1. MANUFACTURER PROVIDED VFD/DISCONNECT PER DIVISION 26 SPECIFICATIONS. 2. REFER TO DETAIL 2M7.2 FOR CONTROLS.

AIR COOLED CHILLER SCHEDULE table with columns: TAG, MANUFACTURER / MODEL, NOMINAL TONNAGE, EER, IPLV, FLOW RATE (GPM), WATER TEMPERATURE (ENTERING, LEAVING), REFRIGERANT TYPE, NUMBER OF REFRIGERANT CIRCUITS, NUMBER OF COMPRESSORS, VOLTAGE, PHASE, FREQUENCY, STARTER TYPE, MCA, MOCP, NOTES.

NOTES: 1. FOR INFORMATION ONLY. CHILLER BEING PROVIDED AND INSTALLED AS PART OF A SEPARATE PROJECT.

CHILLER PUMP SCHEDULE table with columns: TAG, MANUFACTURER, MODEL, SERIES, GPM, HEAD (FT), SUCTION SIZE (IN), DISCHARGE SIZE (IN), MOTOR (RPM), MOTOR (HP), VOLTAGE, PHASE, FREQUENCY (HZ), NOTES.

NOTES: 1. FOR INFORMATION ONLY. PUMP BEING PROVIDED AND INSTALLED AS PART OF A SEPARATE PROJECT.

BOILER PUMP SCHEDULE table with columns: TAG, MANUFACTURER, MODEL, SERIES, GPM, HEAD (FT), SUCTION SIZE (IN), DISCHARGE SIZE (IN), MOTOR (RPM), MOTOR (HP), VOLTAGE, PHASE, FREQUENCY (HZ), NOTES.

NOTES: 1. PROVIDE VFD AND DISCONNECT PER DIVISION 26 SPECIFICATIONS. 2. REFER TO DETAIL 3M7.1 AND 1M7.3 FOR CONTROLS. 3. REFER TO DETAIL 3M5.1. 4. REFER TO DETAIL 1M/2.

EXPANSION TANK SCHEDULE table with columns: TAG, MANUFACTURER, MODEL, SYSTEM SERVED, TANK FILL TEMPERATURE, TANK MAX TEMPERATURE, TANK FILL PRESSURE (PSI), TANK MAX PRESSURE (PSI), REQUIRED TANK VOLUME (GAL.), REQUIRED ACCEPTANCE VOLUME (GAL.), TANK ORIENTATION, TANK DIAPHRAGM, NOTES.

NOTES: 1. TANK TO BE ASME RATED. 2. REFER TO DETAIL 1M5.2 AND 2M5.2. 3. REFER TO DETAIL 1M5.1. 4. REFER TO DETAIL 1M/2.

LOUVER SCHEDULE table with columns: TAG, MANUF., MODEL, DESIGNATION, WIDTH / HEIGHT (IN.), FREE AREA (SQ FT), CFM, VELOCITY (FPM), MOUNTING HEIGHT (A.F.F), NOTES.

NOTES: 1. REFER TO DETAIL 1M5.1. 2. MOUNTING HEIGHT SPECIFIED TO BOTTOM OF LOUVER.

EXHAUST FAN SCHEDULE table with columns: TAG, MANUF., MODEL NO., CFM, E.S.P. (IN. WC), HP, VOLT., PH., EQUIPMENT SERVED, NOTES.

NOTES: 1. MANUFACTURER PROVIDED STARTER/DISCONNECT PER DIVISION 26 SPECIFICATIONS. 2. REFER TO DETAIL 2M5.1. 3. REFER TO DETAIL 10M5.1. 4. REFER TO DETAIL 1M/1 FOR CONTROLS.

ROOF VENT SCHEDULE table with columns: TAG, MANUF., MODEL NO., CFM, VELOCITY (FT/MIN), THROAT SIZE (IN), EQUIPMENT SERVED, NOTES.

NOTES: 1. REFER TO DETAIL 3M5.1.

HYDRONIC UNIT HEATER SCHEDULE table with columns: TAG, MANUF., MODEL NO., CAPACITY (MBH), GPM, ELECTRICAL DATA (VOLT/PH, HP (WATTS)), FAN CFM, WPD, NOTES.

NOTES: 1. PROVIDE STARTER/DISCONNECT PER DIVISION 26. 2. REFER TO DETAIL 8M5.1. 3. REFER TO DETAIL 6M7.1 FOR CONTROLS. 4. PROVIDE A 3-WAY CONTROL VALVE.

AHU UV LIGHT SCHEDULE table with columns: TAG, MANUFACTURER, UV EMITTER LOCATION, SERVICE, CFM, DUCT INFORMATION (WIDTH, HEIGHT, AIR VELOCITY), RATED TEMPERATURE (MIN, MAX), ELECTRICAL (VOLT/PH, AMPS, UV MCA), BULB QUANTITY, BULB LENGTH, NOTES.

NOTES: 1. SIZE INTENSITY FOR COMMON CORONAVIRUS USING DECAY RATE K-FACTOR OF 0.1867 AND A TARGET KILL FACTOR OF 90%. 2. REFER TO AIA DIAGRAMS FOR INSTALLATION ORIENTATION AND LOCATION OF EMITTER. DEVICE SHALL BE ACCESSIBLE FROM ADJACENT PANE. SENSURE DEVICE LOCATION ALLOWS FOR PROPER MAINTENANCE. 3. THE BASIS OF DESIGN HAS UV-C POWER OUTPUT OF 0.8375 WUV/INCH OF BULB. WHEN SUBMITTING ALTERNATIVE MANUFACTURER'S PRODUCTS, PROVIDE PERFORMANCE DOCUMENTATION SHOWING PRODUCT MEETS OR EXCEEDS BASIS OF DESIGN CRITERIA. 4. DIVISION 26 CONTRACTOR SHALL PROVIDE DISCONNECT SWITCH. 5. PROVIDE WITH MANUFACTURER'S MOUNTING BRACKET FOR IN-DUCT MOUNTING APPLICATION. 6. PROVIDE MANUFACTURER'S SAFETY KILL SWITCH. 7. PROVIDE EACH EMITTER ASSEMBLY WITH CONTROL PANEL CAPABLE OF INTERLOCKING WITH THE EQUIPMENT SERVED. 8. VERIFY UNIT DIMENSIONS IN THE FIELD AND CALCULATE ACTUAL KILL BOX LENGTH, WIDTH, AND HEIGHT WITH NEWLY INSTALLED AHU COMPONENTS. 9. PROVIDE FACTORY INSTALLED RADIOMETER.

VAV SHUT-OFF BOX SCHEDULE table with columns: TAG, MANUF., MODEL, SIZE, AIRFLOW (CFM) (MAX PRIMARY, MIN PRIMARY, MAX HEATING), INLET SP (IN. WG), DOWNSTREAM SP (IN. WG), COIL CAPACITY (MBH), AIR TEMPERATURE (ENTERING, LEAVING), WATER PRESSURE DROP (FT WG), WATER FLOW (GPM), WATER TEMPERATURE (ENTERING, LEAVING), COIL ROWS, NC, WEIGHT (LBS), NOTES.

NOTES: 1. REFER TO DETAIL 7M5.1. 2. REFER TO DETAIL 1M5.2 AND 2M5.2. 3. PROVIDE 3-WAY VALVES FOR THE COILS.

AIR SEPARATOR SCHEDULE table with columns: TAG, MANUFACTURER, MODEL, FLOW (GPM), MAX PRESSURE DROP (FT), SYSTEM SERVED, NOTES.

NOTES: 1. COALESCING, STANDARD VELOCITY, REMOVABLE MEDIUM. 2. REFER TO DETAIL 1M5.2 AND 2M5.2.

FAN POWERED VAV SCHEDULE table with columns: TAG, MANUF., MODEL, SIZE, INLET DIA (IN.), AIR FLOW (CFM) (FAN FLOW, PRIMARY, MIN PRIMARY), DOWNSTREAM SP (IN. WG), COIL CAPACITY (MBH), AIR TEMPERATURE (ENTERING, LEAVING), AIR DISCHARGE NC, MAX COIL APP (IN. WG), WATER PRESSURE DROP (FT WG), WATER FLOW (GPM), WATER TEMPERATURE (ENTERING, LEAVING), MOTOR TYPE, HP, VOLTAGE, PHASE, FLA, WEIGHT (LBS), NOTES.

NOTES: 1. REFER TO DETAIL 7M5.1. 2. REFER TO 7M7.1 FOR CONTROLS. 3. PROVIDE STARTER DISCONNECT AS PER DIVISION 26 SPECIFICATIONS.

AIR TERMINAL SCHEDULE table with columns: TAG, MANUF., MODEL, CFM RANGE, PANEL SIZE, NECK SIZE, STYLE, INSTALLATION, FINISH, PRESSURE (IN. WG), NC, THROW, NOTES.

NOTES: 1. REFER TO DETAIL 1M5.1. 2. COORDINATE COLOR WITH ARCHITECTURE FOR WALL OR DUCT MOUNTED AIR TERMINALS.

DUCTLESS SPLIT INDOOR UNIT SCHEDULE table with columns: TAG, MANUFACTURER, MODEL, RATED COOLING CAPACITY BTU/HR, ELECTRICAL (VOLTAGE, MCA, PHASE), NOTES.


NOTES: 1. PROVIDE TEMPERATURE SENSOR TO CONNECT TO DDC CONTROL SYSTEM. 2. PROVIDE THERMOSTAT. 3. REFER TO DETAIL 4M5.1. 4. PROVIDE CONDENSATE PUMP.

AIR COOLED CONDENSING UNIT SCHEDULE table with columns: TAG, MANUFACTURER, MODEL, NOMINAL TONS, DESIGN AMBIENT TEMP (°F), SEER, REF TYPE, NO. OF COMPRESSOR, VOLTAGE, PHASE, ELECTRICAL DATA (FREQUENCY (HZ), MCA, MOCP), EQUIPMENT SERVED, NOTES.

NOTES: 1. PROVIDE STARTER/DISCONNECT PER DIVISION 26. 2. REFER TO DETAIL 4M5.1. 3. PROVIDE CRANKCASE HEATER, LOW-AMBIENT KIT, WINTER START KIT, HAIL GUARD, AND WIND BAFFLE. 4. SIZE AND INSTALL REFRIGERANT PIPING PER MANUFACTURER RECOMMENDATION.

ELECTRIC WALL HEATER SCHEDULE table with columns: TAG, MANUFACTURER, MODEL, CAPACITY (MBH), ELECTRICAL DATA (VOLT/PH, AMPS, CFM), NOTES.

NOTES: 1. PROVIDE INTEGRAL THERMOSTAT WITH LABEL, THERMAL OVERLOAD PROTECTION, BUILT IN DISCONNECT SWITCH AND FAN DELAY SWITCH.

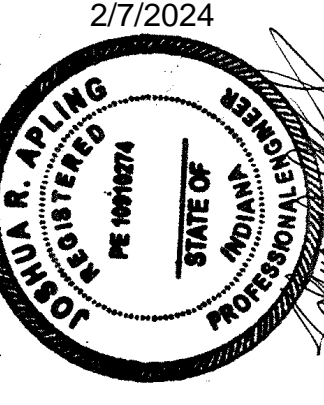

Revision table with columns: NO., DATE, REVISION, including entries for 2/7/24 and 2/16/24.

HANCOCK COUNTY BOARD OF COMMISSIONERS OFFICE RENOVATIONS 123 E. MAIN STREET MECHANICAL EQUIPMENT SCHEDULES - 1 DRAWING NUMBER M6.1 MECHANICAL



Hancock County Office Renovations
Pre-Bid Meeting
February 6, 2024

NAME (Please Print)	COMPANY NAME	TELEPHONE & FAX NUMBER	E-MAIL ADDRESS
Cory Taylor	Hancock County	463 266 9192	Cory.taylor@hancockin. gov
GREGG STARK	BOYLE CONSTRUCTION	511/450-7159	B105@BCM1.US
CHRIS NEAL	SCS CONST.	317-882-0100	ESTIMATING@ SCSCONSTRUCTION.NET
Jay Jeffries	Patterson Horth	765 346 3396	jejeffries@pattersonhorth.com
Loren Huffman	CSUSA	317-710-9334	loren.huffman@comfort systemsusa.com
Anthony Richardson	A. A. Huber	317-800-2983	arichardson@aa.huber.com
Clay Robinson	ENVIRO MAX	317 557 3094	Clay.Robinson@ ENVIRO MAX.COM
Ean Stephenson	AWER	317-888-9945	estephen@area wide electric.com
Jeff Moore	Bloodhound	317-757-7324	Jeffrey MOORE3@bhug.com
Marcus Fulmer	Frontline LLC	317-496-2534	M.Fulmer@Frontline-llc.com
Joey Bastian	Perguson Construction	812-350-3510	jbastian@Perguson-construction.com
Jordan Carsey	emcor - ALC	(317) 670-4736	Jordan_Carsey@emcorgroup.com

<u>Name</u>	<u>Company Name</u>	<u>Phone #</u>	<u>Email</u>
Carlin Darnell	RSQ Fire Protection	317-997-1049	Carlindarnell@rsqfp.com
Cory Shipman	FSG Electric	317-727-9706	cory.shipman@fsgi.com
Ben Dornbusch	Florian Fire Protection	513-256-7671	ben.dornbusch@florinfa.com